

WATER WELL DRILLERS LOG

~~W-106~~
A W 14
Date: 4-10-62, 19 62

Driller: Jas. R. Lyse (Name) County: Pondera


(1) Owner of Land: B. M. Lynch (Name)
 Marks, Miss (Address)
 (2) Location: 1/4, 1/4, Sec. 36 T10R6 S W
 3 miles (distance) East (direction) of Pope (Nearest Town)
 (3) Topography: Hills (Hilly) (Level)
 (4) Purpose of Well: Domestic (Domestic, Irrigation, Municipal, Industrial, Other)

Description & Color of Materials Sand, Clay, Red Clay, Shell, etc.	Thick- ness Feet	Depth Feet
clay	0	20
black clay shale	20	115
sandy clay	115	140
upheaving shale	140	158

Information upon completion of well:

(1) Diameter 2 inches.
 (2) Total Depth 158 feet.
 (3) Water Level 70 feet below top of ground.
 (4) Cased to 152, Size 2"
 (5) Screen: Size 1/4, Length 6'
 (6) Were any formations sealed against pollution?
 yes, no

If YES depth of formation _____
 Why _____
 Drillers Remarks: _____

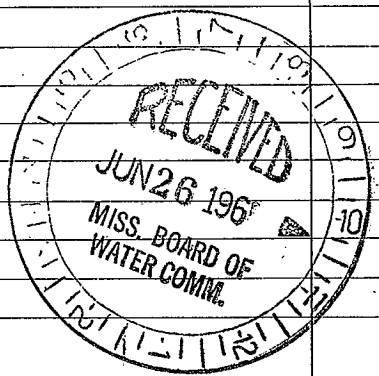

(Use Back Side)

Well No.

