

~~W~~ W-15
1-12-63

CODED

WATER WELL DRILLERS LOG

Date: 1-12, 1963, Driller: JAMES R. Lipe county Panola
(Name)

(1) Owner of Land:	Description & Color of Materials Sand, Clay, Red Clay, Shell, etc.	Thick- ness Feet	Depth Feet
<u>Clifton Arnold</u> (Name)	<u>Clay red</u>	<u>0</u>	<u>20</u>
<u>Pope, Miss</u> (Address)	<u>pink clay</u>	<u>20</u>	<u>35</u>
(2) Location: <u>1/4</u> , <u>1/4</u> , Sec <u>22</u> , T. <u>10R</u> S. <u>6</u> <u>5</u> miles <u>East</u> of <u>Pope</u> (distance) (direction) (Nearest Town)	<u>gravel + sand</u>	<u>3.5</u>	<u>60</u>
(3) Topography: <u>Hilly</u> (Hilly) (Flat) (Level)	<u>Sand + blk. Clay</u>	<u>60</u>	<u>100</u>
(4) Purpose of Well: <u>Domestic</u> (Domestic Irrigation Municipal, Industrial, Other)	<u>W/running Sand</u>	<u>100</u>	<u>136</u>

Information upon completion of well:


- (1) Diameter 2 inches.
- (2) Total Depth 136' feet.
- (3) Water Level 75 feet below top of ground.
- (4) Cased to 127, Size 2"
- (5) Screen: Size 1/4, Length 6'
- (6) Were any formations sealed against pollution?

 yes, no.

If YES depth of formation

Why

Drillers Remarks:

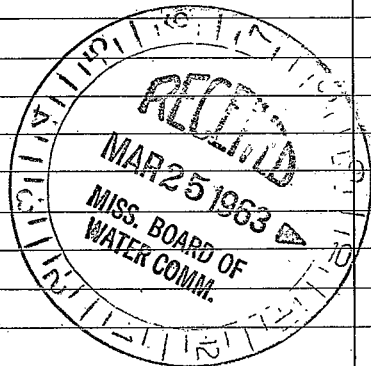

(Use Back Side)

Well No.

