

MISSISSIPPI BOARD OF WATER COMMISSIONERS

PANOLA

W 16
5-3-63

WATER WELL DRILLERS LOG

COPIED

Date: 5/3, 19 63 Driller: James R. Lipe County Panola

(1) Owner of Land: Marion Lee
(Name)
Pope
(Address)

(2) Location: $\frac{1}{4}$, $\frac{1}{4}$, Sec 32 T27R6
N W
8 miles East, of Pope
(distance) (direction) (Nearest Town)

(3) Topography: Hilly
(Hilly) (Flat) (Level)

(4) Purpose of Well: Agriculture
(Domestic, Irrigation, Municipal, Industrial, Other)

Description & Color of Materials Sand, Clay, Red Clay, Shell, etc.	Thick- ness Feet	Depth Feet
Clay	0	10
Clay & sand	10	25
Clay & gravel	25	50
Gravel	50	105
Gravel & sand	65	80
Expanding Sand	80	115

Information upon completion of well:

(1) Diameter 2 inches.


(2) Total Depth 115 feet.

(3) Water Level 65 feet below top of ground.

(4) Cased to 108, Size 2"

(5) Screen: Size 1/4, Length 6'

(6) Were any formations sealed against pollution?
 _____ yes, _____ no.

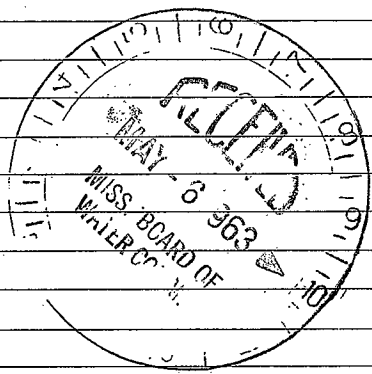

If YES depth of formation _____

Why _____

Drillers Remarks: _____

Retain this copy for your office files.

(Use Back Side)

Well No.

