

WATER WELL DRILLERS LOG

CODED

PANOLA

Date: 10-25, 1963, Driller: James R. Lyle County: Panola

R W 20

(Name)

(1) Owner of Land:	Description & Color of Materials Sand, Clay, Red Clay, Shell, etc.	Thick- ness Feet	Depth Feet
<p>10-25-63 <u>Jak Bunnett</u> (Name) <u>Batesville, Miss.</u> (Address)</p>	<p><u>Clay</u> <u>Clay & sand</u> <u>red sand</u></p>	<p><u>0</u> <u>25</u> <u>65</u></p>	<p><u>25</u> <u>65</u> <u>92</u></p>
<p>(2) Location: <u>1/4</u>, <u>1/4</u>, Sec. <u>1</u> T<u>10</u>R<u>6</u>S<u>W</u></p>			
<p><u>15</u> miles <u>east</u> of <u>Batesville</u> (distance) (direction) (Nearest Town)</p>			
<p>(3) Topography: <u>Hilly</u> (Hilly) (Flat) (Level)</p>			
<p>(4) Purpose of Well: <u>Domestic</u> (Domestic Irrigation Municipal, Industrial, Other)</p>			


Information upon completion of well:

- (1) Diameter 2 inches.
- (2) Total Depth 92 feet.
- (3) Water Level 50 feet below top of ground.
- (4) Cased to 24, Size 2"
- (5) Screen: Size 1 1/4", Length 6'
- (6) Were any formations sealed against pollution?
 yes, no.

If YES depth of formation _____

Why _____

Drillers Remarks: _____

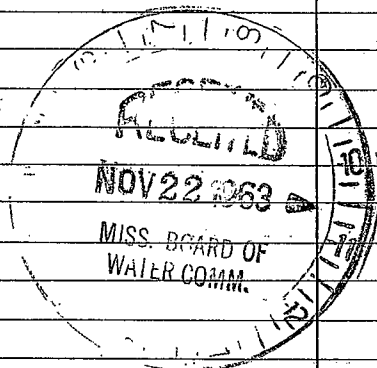

(Use Back Side)

Well No. 17

