

W21

2-27-64

WATER WELL DRILLERS LOG

CODED

Date: Feb 27, 1964, Driller: Frank Taylor <sup>2182</sup> County Panola  
 (Name)

(1) Owner of Land: Robert Smith  
 (Name)  
Pape Mrs  
 (Address)  
 (2) Location: 1/4, 1/4, Sec. 23 T. 10 S. R. 6 W.  
9 miles east of Pape  
 (distance) (direction) (Nearest Town)  
 (3) Topography: Hilly  
 (Hilly) (Flat) (Level)  
 (4) Purpose of Well: Domestic  
 (Domestic Irrigation  
 Municipal, Industrial, Other)


| Description & Color of Materials<br>Sand, Clay, Red Clay, Shell, etc. | Thick-<br>ness<br>Feet | Depth<br>Feet |
|---|------------------------|---------------|
| <u>Sand</u>   | <u>0</u>               | <u>45</u>     |
| <u>Rock</u>   | <u>45</u>              | <u>-</u>      |
| <u>Clay</u>   | <u>45</u>              | <u>135</u>    |
| <u>water sand</u>   | <u>135</u>             | <u>142</u>    |

Information upon completion of well:

(1) Diameter 2 inches.  
 (2) Total Depth 142 feet.  
 (3) Water Level 100 feet below top of ground.  
 (4) Cased to 126, Size 2  
 (5) Screen: Size 1/4, Length 6  
 (6) Were any formations sealed against pollution?  
 \_\_\_\_\_ yes, \_\_\_\_\_ no.

If YES depth of formation \_\_\_\_\_  
 Why \_\_\_\_\_

Drillers Remarks: \_\_\_\_\_  
 \_\_\_\_\_  
 \_\_\_\_\_

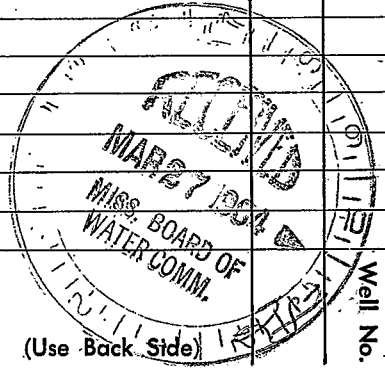

(Use Back Side)

