

Panola
W 22
1-2-69

MISSISSIPPI
 BOARD OF WATER COMMISSIONERS
 416 North State Street
 Jackson, Mississippi 39201

CODED

WATER WELL DRILLERS LOG

1-2 1969 JAMES R. LIFE Panola
 date well completed firm name county well located

LANDOWNER: Rodney Hentz

description of formations encountered

from

to

Courtland

Miss.

(mailing address)

WELL LOCATION:

sec. 6 T. 10 N. R. 6 E.
8 miles S east of Batesville
 (distance) (direction) (nearest town)

Clay	0	20
SAND	20	40
Sand and Pea gravel	40	60
Gravel	60	80
Coarse sand	80	100
" "	100	120
" "	120	131

WELL PURPOSE: home
 (home, irrigation, municipal, industrial)

WELL COMPLETION DATA:

- diameter (inches) 4"
- total depth (feet) 131
- static water level (feet) 100 below top of ground.
- casing Plastic, 122,
 (material) (depth)
4"
 (size) If telescope see back.
- screen 9, 122
 (length) (depth to top)
4", Plastic
 (size) (material)
- pump 3/4, 10
 (HP) (yield gpm)
Elec.
 (type power)
- electric log No
 (yes or no)

(organization running log)


- how well bottom plugged, 4"
Plastic plug

DRILLERS REMARKS:

JAN 14 1969
 MISS. BD. OF
 WATER COM.

If well telescopes please sketch and show depths.

GROUND LEVEL

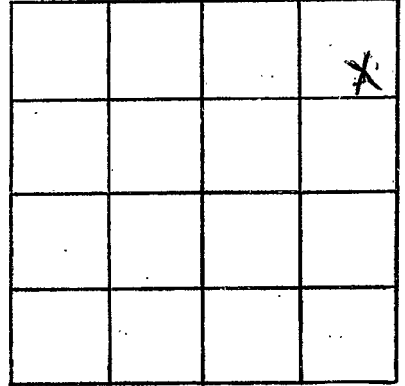

SECTION 6

Please indicate well location X.

ADDITIONAL INFORMATION

If more than one screen,
show locations of each on sketch.