

**CODED**

MISSISSIPPI  
BOARD OF WATER COMMISSIONERS  
416 North State Street  
Jackson, Mississippi 39201

PANOLA  
W 24  
7-20-70

**WATER WELL DRILLERS LOG**

July 20 1970 Pipe Well Co. Panel 2  
date well completed firm name county well located

LANDOWNER:  
Prentiss McMinn  
Courtland  
(mailing address)

description of formations encountered	from	to
Clay	0	20
sand	20	40
l	40	60
l	60	80
l	80	90

WELL LOCATION:  
sec. 8 T 10 N R 6 E  
2 miles SE of Eureka  
(distance) (direction) (nearest town)

WELL PURPOSE: home  
(home, irrigation, municipal, industrial)

WELL COMPLETION DATA:

(1) diameter (inches) 4  
 (2) total depth (feet) 96  
 (3) static water level (feet) 60 below top of ground.  
 (4) casing PVC, 86 (material) (depth)  
 4 (size) if telescope see back.  
 (5) screen 10, 86 (length) (depth to top)  
 4, PVC (size) (material)  
 (6) pump 1/3, 10 (HP) (yield gpm)  
 Elec. (type power)  
 (7) electric log no (yes or no)  
 no (organization running log)  
 (8) how well bottom plugged PVC plug

**CODED**


AUG 24 1970

DRILLERS REMARKS:

MISS. BL. OF  
WATER COM.

If well telescopes please sketch and show depths.

GROUND LEVEL

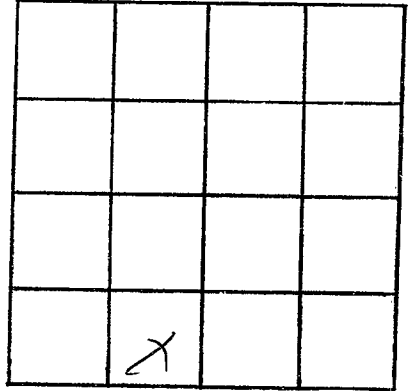

SECTION 8

Please indicate well location X.

ADDITIONAL INFORMATION

If more than one screen,  
show locations of each on sketch.