

PANOIA
W 25
7-21-70

MISSISSIPPI
BOARD OF WATER COMMISSIONERS
416 North State Street
Jackson, Mississippi 39201

CODED

WATER WELL DRILLERS LOG

July 21 1970 PIPE WELL CO PANOIA
date well completed firm name county well located

LANDOWNER:
Melvin Reagan
Courtland, Miss
(mailing address)

description of formations encountered	depth	
	from	to
clay	0	20
gravel	20	40
ll	40	60
sand	60	80
ll	80	105

WELL LOCATION:
sec. 6 T. 10 N R. 6 E
1/4 miles SE of Eureka
(distance) (direction) (nearest town)

WELL PURPOSE: home
(home, irrigation, municipal, industrial)

WELL COMPLETION DATA:

(1) diameter (inches) 4

(2) total depth (feet) 105

(3) static water level (feet) 70 below top of ground.

(4) casing PVC 95
(material) (depth)
4 if telescope see back.
(size)

(5) screen 10 95
(length) (depth to top)
4 PVC
(size) (material)

(6) pump 1/2 8
(HP) (yield gpm)
Elec
(type power)

(7) electric log no
(yes or no)
no
(organization running log)

(8) how well bottom plugged PVC plug


CODED

AUG 24 1970

DRILLERS REMARKS:

If well telescopes, please sketch and show depths.

GROUND LEVEL

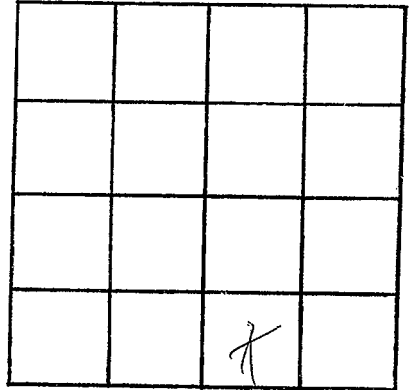

SECTION 6

Please indicate well location X.

ADDITIONAL INFORMATION

If more than one screen,
show locations of each on sketch.