

PANOLA

W 26

10-6-70

MISSISSIPPI  
 BOARD OF WATER COMMISSIONERS  
 416 North State Street  
 Jackson, Mississippi 39201

**CODED**

WATER WELL DRILLERS LOG

10-6

1970 JAMES R. LIPE

Panola

date well completed

firm name

county well located

LANDOWNER: Cecil MEMM

Courtland

Miss.

(mailing address)

WELL LOCATION:

sec. 16 T. 10 N. R. 6 E

4 miles East of Courtland  
(distance) (direction) (nearest town)

WELL PURPOSE: HOME  
(home, irrigation, municipal, industrial)

WELL COMPLETION DATA:

- (1) diameter (inches) 4
- (2) total depth (feet) 124
- (3) static water level (feet) 50 below above top of ground.
- (4) casing PVC, 114 (material) (depth)  
(size) if telescope see back.
- (5) screen 10, 114 (length) (depth to top)  
4, PVC (size) (material)
- (6) pump 3/4, 10 (HP) (yield gpm)  
Elec. (type power)
- (7) electric log NO (yes or no)

(organization running log)

(8) how well bottom plugged PVC Plug

description of formations encountered

from to

C129	0	20
sand	20	40
li	40	60
gravel	60	80
sand	80	100
li	100	124

**CODED**


DEC 3 1970

MISS. BD. OF WATER COMMISSIONERS

DRILLERS REMARKS:

If well telescopes please sketch and show depths.

GROUND LEVEL

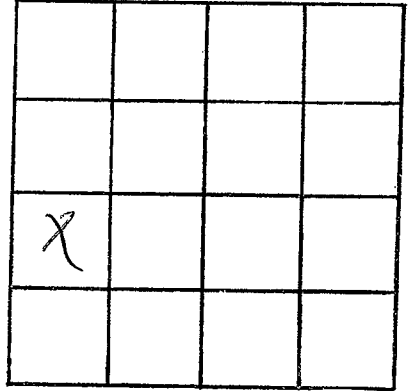

SECTION 16

Please indicate well location X.

ADDITIONAL INFORMATION

Lined area for additional information.

If more than one screen, show locations of each on sketch.