

PANOLA  
W 27.  
10-11-72

MISSISSIPPI  
BOARD OF WATER COMMISSIONERS  
416 North State Street  
Jackson, Mississippi 39201

**CODED**

WATER WELL DRILLERS LOG

10-11 1972 JAMES R LIPE Panola  
date well completed firm name county well located

LANDOWNER: Ruth Anthony  
POPE  
MISS.  
(mailing address)

description of formations encountered	from	to
clay	0	20
sand	20	40
sand and clay	40	60
ll ll ll	60	80
sand	80	100

WELL LOCATION:  
sec 23 T 10 N R 6 E  
3 miles East of POPE  
(distance) (direction) (nearest town)

WELL PURPOSE: HOME  
(home, irrigation, municipal, industrial)

- WELL COMPLETION DATA:
- (1) diameter (inches) 4"
  - (2) total depth (feet) 100
  - (3) static water level (feet) 90 below above top of ground.
  - (4) casing PVC 98', (material) (depth)  
4 if telescope see back. (size)
  - (5) screen 8, 98 (length) (depth to top)  
4, PVC (size) (material)
  - (6) pump 3/4, 10 (HP) (yield gpm)  
Elec. (type power)
  - (7) electric log no (yes or no)  
no (organization running log)
  - (8) how well bottom plugged, PVC  
PIV


**CODED**

NOV - 1 1972

DRILLERS REMARKS:

If well telescopes please sketch and show depths.

GROUND LEVEL

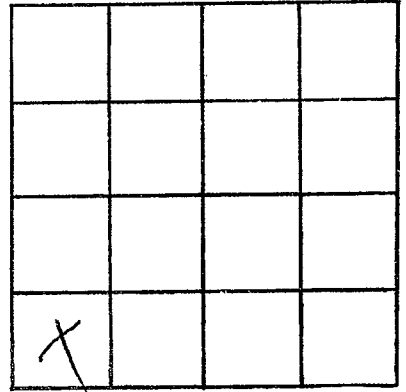

SECTION 23

Please indicate well location X.

ADDITIONAL INFORMATION

If more than one screen,  
show locations of each on sketch.