

J. B. Cain

MISSISSIPPI  
BOARD OF WATER COMMISSIONERS  
416 North State Street  
Jackson, Mississippi 39201

**CODED**

WATER WELL DRILLERS LOG

<i>Ponola</i>
<i>W 29</i>
<i>9-68</i>

date well completed 19 *9-7-68* firm name *Ponola* county well located

LANDOWNER: *Shane*  
*Batesville Miss*  
(mailing address)


description of formations encountered	from	to
<i>Red Cl</i>	<i>0</i>	<i>60</i>
<i>Sand Cl</i>	<i>60</i>	<i>90</i>
<i>Blue Cl</i>	<i>90</i>	<i>120</i>
<i>Sand</i>	<i>120</i>	<i>150</i>

WELL LOCATION:  
sec. *13* T *10* N R *6* E  
*15* miles *E* of *Batesville*  
(distance) (direction) (nearest town)

WELL PURPOSE:  
(home, irrigation, municipal, industrial)

- WELL COMPLETION DATA:
- (1) diameter (inches) *4"*
  - (2) total depth (feet) *150*
  - (3) static water level (feet) *54* below top of ground
  - (4) casing *Plastic 140*  
(material) (depth)  
*2* If telescope see back.  
(size)
  - (5) screen *2 145*  
(length) (depth to top)  
*2 Plastic*  
(size) (material)
  - (6) pump *34 16*  
(HP) (yield gpm)  
*Elect*  
(type power)
  - (7) electric log *No*  
(yes or no)
  - (8) how well bottom plugged *Work Bottom*


**CODED**

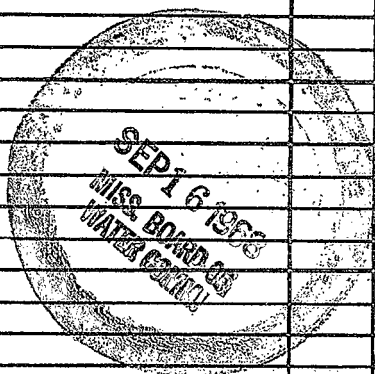

DRILLERS REMARKS:

If well telescopes please sketch and show depths.

GROUND LEVEL

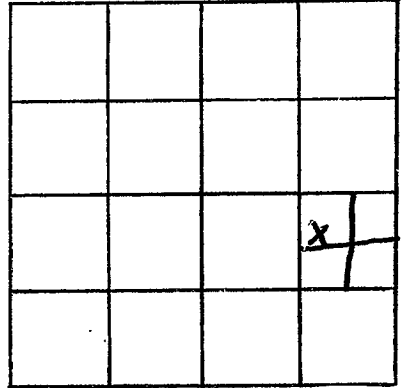

SECTION 13

Please indicate well location X.

ADDITIONAL INFORMATION

If more than one screen,  
show locations of each on sketch.