

PANOLA
W 30
4-2-73

MISSISSIPPI
BOARD OF WATER COMMISSIONERS
 416 North State Street
 Jackson, Mississippi 39201

CODED

WATER WELL DRILLERS LOG

4-2 1973 JAMES A. LIPE Panola
 date well completed firm name county well located

LANDOWNER:	description of formations encountered	from	to
<u>Donor Vick</u> <u>Pope Miss.</u> (mailing address)	<u>Top soil</u>	<u>0</u>	<u>20</u>
	<u>sand</u>	<u>20</u>	<u>40</u>
	<u>cc</u>	<u>40</u>	<u>60</u>
	<u>Gravel</u>	<u>60</u>	<u>80</u>
	<u>sand and gravel</u>	<u>80</u>	<u>100</u>
	<u>sand</u>	<u>100</u>	<u>120</u>
	<u>cc</u>	<u>120</u>	<u>157</u>

WELL LOCATION:
 sec. 29 T 10 N R. 6 E
8 miles East of Pope
 (distance) (direction) (nearest town)

WELL PURPOSE: HOME
 (home, irrigation, municipal, industrial)

- WELL COMPLETION DATA:**
- diameter (inches) 4"
 - total depth (feet) 157
 - static water level (feet) 100' below above top of ground.
 - casing PVC, 147'
(material) (depth)
4 if telescope see back.
(size)
 - screen 10, 147
(length) (depth to top)
4, PVC
(size) (material)
 - pump 5, 85
(HP) (yield gpm)
ELEC.
(type power)
 - electric log NO
(yes or no)
NO
(organization running log)
 - how well bottom plugged PVC
PLUG


CODED

MAY 6 1973

DRILLERS REMARKS:

If well telescopes please sketch and show depths.

GROUND LEVEL

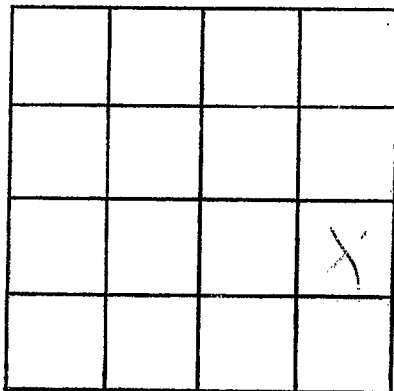

SECTION 29

Please indicate well location X.

ADDITIONAL INFORMATION

If more than one screen,
show locations of each on sketch.