

PANOLA  
W 35  
6-7-73

MISSISSIPPI  
BOARD OF WATER COMMISSIONERS  
416 North State Street  
Jackson, Mississippi 39201

CODED

WATER WELL DRILLERS LOG


6-7 1973 James R. Lipe Panola  
date well completed firm name county well located

LANDOWNER:	description of formations encountered	from	to
Corene Peters Pope Miss. (mailing address)	Clay	0	20
	Sand	20	40
	Black Clay	40	60
	Sand and clay	60	140
	Sand	140	190
WELL LOCATION: sec. 16 T 10 N R 6 E 8 miles east of Pope (distance) (direction) (nearest town)			
WELL PURPOSE: (home irrigation, municipal, industrial)			
WELL COMPLETION DATA:			
(1) diameter (inches) 4"			
(2) total depth (feet) 190			
(3) static water level (feet) 80 below top of ground.			
(4) casing PVC 180 (material) (depth)			
4 If telescope see back. (size)			
(5) screen 10 180 (length) (depth to top)			
4 PVC (size) (material)			
(6) pump 3/4 10 (HP) (yield gpm)			
elec. (type power)			
(7) electric log no (yes or no)			
no (organization running log)			
(8) how well bottom plugged PVC Plog			
DRILLERS REMARKS:			

CODED

If well telescopes please sketch and show depths.

GROUND LEVEL

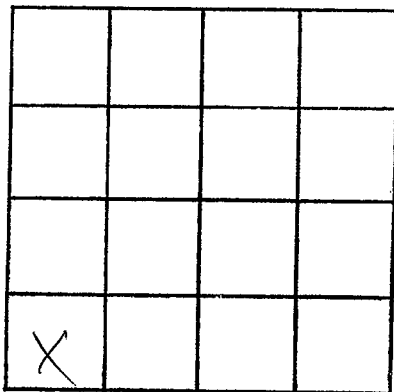

SECTION 8

Please indicate well location X.

ADDITIONAL INFORMATION

If more than one screen,  
show locations of each on sketch.