

PANOLA

W 36

6-14-73

MISSISSIPPI BOARD OF WATER COMMISSIONERS 416 North State Street Jackson, Mississippi 39201

CODED

WATER WELL DRILLERS LOG

6-14

date well completed

1973 James R. Lipe

firm name

Panola

county well located

LANDOWNER:

E. D. Regan

Pope, Miss.

(mailing address)

description of formations encountered

red clay

" sand

" "

clay

" "

white sand

from to

0 20

20 40

40 60

60 80

80 100

100 120

120 132

WELL LOCATION:

sec. 23 T 10 N R 6 E 5 miles east of Pope (distance) (direction) (nearest town)

WELL PURPOSE:

(home) irrigation, municipal, industrial

WELL COMPLETION DATA:

- (1) diameter (inches) 4
(2) total depth (feet) 132
(3) static water level (feet) 90 below top of ground.
(4) casing PVC, 122 (material), (depth) 4 (size) if telescope see back.
(5) screen 10 (length), 122 (depth to top) 4 (size), PVC (material)
(6) pump 3/4 (HP), 10 (yield gpm) elec (type power)
(7) electric log NO (yes or no) NO (organization running log)
(8) how well bottom plugged PVC Plug


CODED

DRILLERS REMARKS:

JUN 5 1973

If well telescopes please sketch and show depths.

GROUND LEVEL

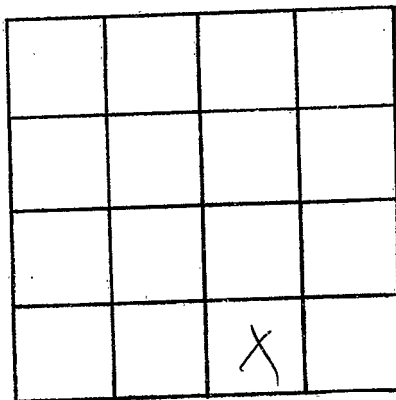

SECTION 23

Please indicate well location X.

ADDITIONAL INFORMATION

If more than one screen,
show locations of each on sketch.