

PANOLA  
W37  
1-16-73

MISSISSIPPI  
BOARD OF WATER COMMISSIONERS  
416 North State Street  
Jackson, Mississippi 39201

CODED

WATER WELL DRILLERS LOG

1-16 1973  
date well completed

James R. Lipe  
firm name

Panola  
county well located

LANDOWNER:  
Luther R. SIMMONS  
Courtland Miss.  
(mailing address)

description of formations encountered	from	to
TOP soil	0	20
sand	20	40
''	40	60
''	60	70
Clay	70	80
''	80	100
''	100	120
''	120	140
sand and clay	140	160
sand	160	180
''	180	194

WELL LOCATION:  
sec. 3 T. 10 N. R. 6 E  
6 miles East of POPE  
(distance) (direction) (nearest town)

WELL PURPOSE: HOME  
(home, irrigation, municipal, industrial)

- WELL COMPLETION DATA:
- (1) diameter (inches) 4"
  - (2) total depth (feet) 194
  - (3) static water level (feet) 80 below top of ground.
  - (4) casing PVC, 184 (material) (depth)  
4 (size) if telescope see back.
  - (5) screen 10, 184 (length) (depth to top)  
4, PVC (size) (material)
  - (6) pump 3/4, 10 (HP) (yield gpm)  
Elec. (type power)
  - (7) electric log no (yes or no)  
no (organization running log)


(8) how well bottom plugged PVC Plug

DRILLERS REMARKS:

FEB 8 1973

If well telescopes please sketch and show depths.

GROUND LEVEL

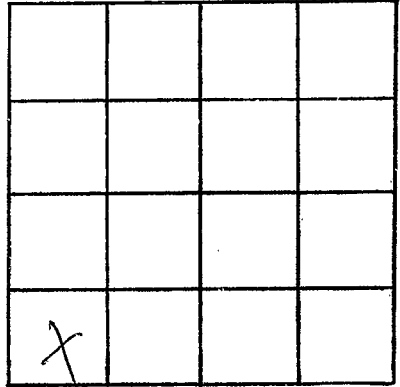

SECTION 3

Please indicate well location X.

ADDITIONAL INFORMATION

If more than one screen, show locations of each on sketch.