

PANOLA  
W 39  
12-4-73

MISSISSIPPI  
BOARD OF WATER COMMISSIONERS  
416 North State Street  
Jackson, Mississippi 39201

CODED

WATER WELL DRILLERS LOG

12-4 date well completed 1973 Lipe well Co firm name Panola county well located

LANDOWNER:  
G. C. Hubbard  
Courtland Miss.  
(mailing address)


WELL LOCATION:  
sec. 12 T 10 N R 6 E  
5 miles east of Courtland  
(distance) (direction) (nearest town)

WELL PURPOSE:  
(home) irrigation, municipal, industrial

- WELL COMPLETION DATA:
- (1) diameter (inches) 4
  - (2) total depth (feet) 139
  - (3) static water level (feet) 60 below above top of ground.
  - (4) casing PVC, 129 (material), (depth)  
4 (size) if telescope see back.
  - (5) screen 10, 129 (length), (depth to top)  
4, PVC (size), (material)
  - (6) pump 3/4, 10 (HP), (yield gpm)  
elec. (type power)
  - (7) electric log NO (yes or no)  
NO (organization running log)
  - (8) how well bottom plugged PVC plug

description of formations encountered	from	to
TOP SOIL	0	20
SAND	20	40
CLAY	40	60
SAND	60	80
CLAY	80	100
SAND	100	120
CLAY	120	139

CODED

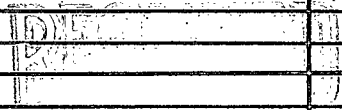


JAN 7 1974

DRILLERS REMARKS:

If well telescopes please sketch and show depths.

GROUND LEVEL

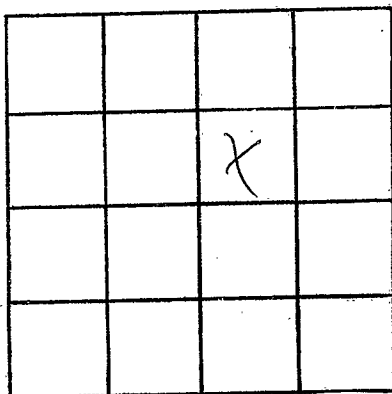

SECTION 12

Please indicate well location X.

ADDITIONAL INFORMATION

If more than one screen,  
show locations of each on sketch.