

PANOLA
W 42
3-8-74

MISSISSIPPI
BOARD OF WATER COMMISSIONERS
416 North State Street
Jackson, Mississippi 39201

CODED

WATER WELL DRILLERS LOG

3-8 date well completed 1974 Life Well Co. firm name Panola county well located

LANDOWNER:
C. L. HOUCK
Courtland Miss.
(mailing address)

description of formations encountered	from	to
TOP SOIL	0	20
red sand	20	40
pea gravel	40	60
sand and gravel	60	80
sand	80	100
white sand	100	140

WELL LOCATION:
sec. 10 T 10 N R 6 E
8 miles East of Courtland
(distance) (direction) (nearest town)

WELL PURPOSE:
(home, irrigation, municipal, industrial)

WELL COMPLETION DATA:

(1) diameter (inches) 4"

(2) total depth (feet) 140

(3) static water level (feet) 80 below top of ground.

(4) casing PVC 138 (material) (depth)

4 If telescope see back. (size)

(5) screen 8' 138 (length) (depth to top)

4 PVC (size) (material)

(6) pump 1 1/2 90 (HP) (yield gpm)

elec (type power)

(7) electric log no (yes or no)

no (organization running log)

(8) how well bottom plugged PVC plug

CODED


RECEIVED

APR - 3 1974

DRILLERS REMARKS:

If well telescopes please sketch and show depths.

GROUND LEVEL

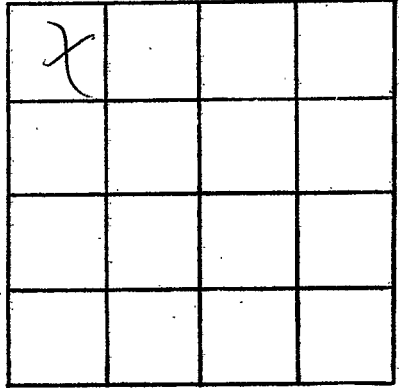

SECTION 10

Please indicate well location X.

ADDITIONAL INFORMATION

If more than one screen, show locations of each on sketch.