

PANOLA
W 43
4-30-74

MISSISSIPPI
BOARD OF WATER COMMISSIONERS
416 North State Street
Jackson, Mississippi 39201 **CODED**

WATER WELL DRILLERS LOG

4-30 1974 Lipe Well Co. Panola
date well completed firm name county well located

LANDOWNER:
R. W. Dees
Pope Miss.
(mailing address)

description of formations encountered	from	to
Top Soil	0	20
Sand	20	40
sand and clay	40	60
Sand	60	80
cc	80	96

WELL LOCATION:
sec 19 T 10 N R 6 E
8 miles east of Pope
(distance) (direction) (nearest town)

WELL PURPOSE:
(home, irrigation, municipal, industrial)

- WELL COMPLETION DATA:
- (1) diameter (inches) 4
 - (2) total depth (feet) 96
 - (3) static water level (feet) 60 below top of ground.
 - (4) casing PVC 892 (material) (depth)
4 If telescope see back. (size)
 - (5) screen 4 92 (length) (depth to top)
4 PVC (size) (material)
 - (6) pump 3/4 10 (HP) (yield gpm)
elec. (type power)
 - (7) electric log no (yes or no)
no (organization running log)
 - (8) how well bottom plugged PVC plug


CODED

MAY 20 1974
MISS. BD. OF WATER COMMISSIONERS

DRILLERS REMARKS:

If well telescopes please sketch and show depths.

GROUND LEVEL

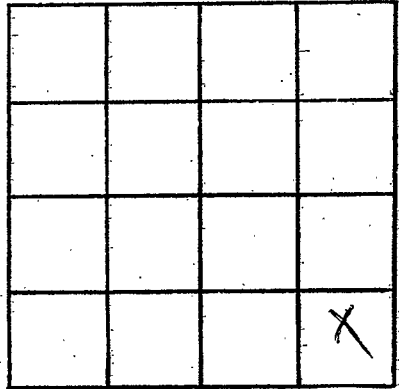

SECTION 19

Please indicate well location X.

ADDITIONAL INFORMATION

If more than one screen,
show locations of each on sketch.