

PANOLA  
 W 44  
 S-10-74

MISSISSIPPI  
 BOARD OF WATER COMMISSIONERS  
 416 North State Street  
 Jackson, Mississippi 39201

CODED

WATER WELL DRILLERS LOG

5-10 1974 Life well Co. Panola  
 date well completed firm name county well located

LANDOWNER:  
 John Meek  
 Batesville Miss.  
 (mailing address)

description of formations encountered	from	to
TOP soil	0	20
sand	20	40
gravel	40	60
LI	60	80
LI	80	100
sand	100	125

WELL LOCATION:  
 sec. 6 T. 10 N. R. 6 E.  
 7 miles S. east of Batesville  
 (distance) (direction) (nearest town)

WELL PURPOSE:  
 (home irrigation, municipal, industrial)

- WELL COMPLETION DATA:
- (1) diameter (inches) 4
  - (2) total depth (feet) 125
  - (3) static water level (feet) 40 below top of ground.
  - (4) casing PVC 115 (material) (depth)  
 4 (size) if telescope see back.
  - (5) screen 10 115 (length) (depth to top)  
 4 PVC (size) (material)
  - (6) pump 3/4 10 (HP) (yield gpm)  
 eipc (type power)
  - (7) electric log no (yes or no)  
 no (organization running log)
  - (8) how well bottom plugged PVC Plug

CODED


DRILLERS REMARKS:

1974

MISS. Bd. OF WATER COMMISSIONERS

If well telescopes please sketch and show depths.

GROUND LEVEL

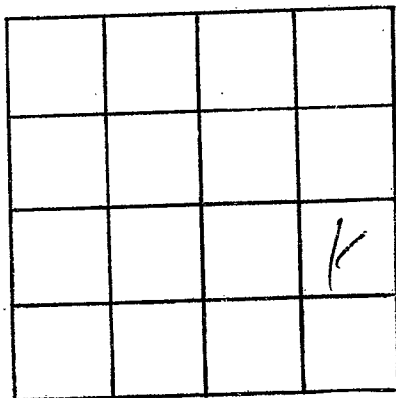

SECTION 6

Please indicate well location X.

ADDITIONAL INFORMATION

If more than one screen, show locations of each on sketch.