

PANOLA
W 96
6-20-74

MISSISSIPPI
BOARD OF WATER COMMISSIONERS
416 North State Street
Jackson, Mississippi 39201

CODED

WATER WELL DRILLERS LOG

6-20 1974 Lipe Well Co. Panola
date well completed firm name county well located

LANDOWNER:

Ray Murrell

Pope Miss.
(mailing address)

description of formations encountered

from to

Top soil	0	20
Sand	20	40
Gravel	40	60
lc	60	80
sand	80	100
ll	100	120
ll	120	140
ll	140	154

WELL LOCATION:

sec. 34 T 10 N R 6 E
2 miles east of Pope
(distance) (direction) (nearest town)

WELL PURPOSE:

(home) irrigation, municipal, industrial

CODED

WELL COMPLETION DATA:


- (1) diameter (inches) 4
- (2) total depth (feet) 154
- (3) static water level (feet) 90 below top of ground.
- (4) casing PVC, 144 (depth)
4 (size) if telescope see back.
- (5) screen 10 (length), 144 (depth to top)
4 (size), PVC (material)
- (6) pump 3/4 (HP), 10 (yield gpm)
elec. (type power)
- (7) electric log no (yes or no)
no (organization running log)
- (8) how well bottom plugged PVC plug

RECEIVED
JUL 3 1974

DRILLERS REMARKS:

If well telescopes please sketch and show depths.

GROUND LEVEL

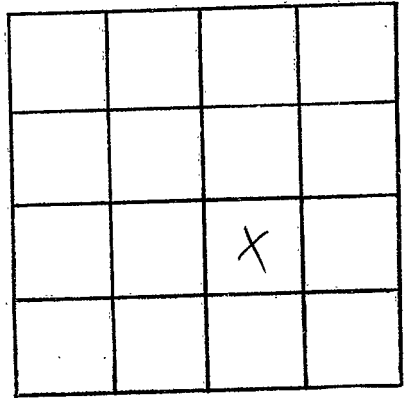

SECTION 34

Please indicate well location X.

ADDITIONAL INFORMATION

If more than one screen, show locations of each on sketch.