

Big Stream

MISSISSIPPI  
BOARD OF WATER COMMISSIONERS  
416 North State Street  
Jackson, Mississippi 39201

INDEXED

138

PANOLA  
W 48  
10-10-74

WATER WELL DRILLERS LOG

Oct 10 1974 J B Cain Panola  
date well completed firm name county well located

LANDOWNER: Ray D. Mack  
H. Rieka  
(Eureka Springs)  
(mailing address)

description of formations encountered	from	to
clay & sand	0	30
Gravel	30	75
sand	75	120

WELL LOCATION:  
sec. 5 T10 N. R. 6 E  
0 miles 0 of Eureka Springs  
(distance) (direction) (nearest town)

WELL PURPOSE:  
(home, irrigation, municipal, industrial)

WELL COMPLETION DATA:

(1) diameter (inches) 4"

(2) total depth (feet) 120

(3) static water level (feet) 90 below top of ground.

(4) casing Plastic, 120, (material) (depth)

(size) if telescope see back.

(5) screen 10, 120 (length) (depth to top)  
4" Plastic (size) (material)


(6) pump 1/2, 10 (HP) (yield gpm)  
Elec (type power)

(7) electric log No (yes or no)

(organization running log)

(8) how well bottom plugged Plug

INDEXED

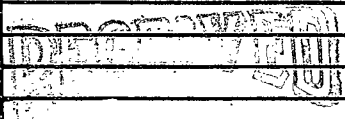


JAN 13 1975

DRILLERS REMARKS:

MISS. BD. OF WATER COMMISSIONERS

If well telescopes please  
sketch and show depths.

GROUND LEVEL

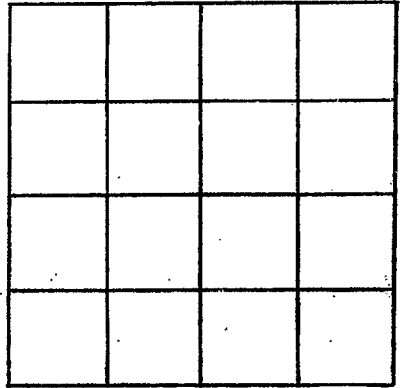

SECTION \_\_\_\_\_

Please indicate well location X.

ADDITIONAL INFORMATION

If more than one screen,  
show locations of each on sketch.