

Panola  
W50  
8-20-75

MISSISSIPPI  
 BOARD OF WATER COMMISSIONERS  
 416 North State Street  
 Jackson, Mississippi 39201

CODED

WATER WELL DRILLERS LOG


8-20 1975 LIPE Well Co. Panola  
 date well completed firm name county well located

LANDOWNER:	description of formations encountered	from	to
<u>Albert Davis</u>			
<u>Pope Miss,</u>	<u>red sand</u>	<u>20</u>	<u>40</u>
(mailing address)	<u>    "    "</u>	<u>40</u>	<u>60</u>
WELL LOCATION:	<u>white clay and sand</u>	<u>60</u>	<u>80</u>
sec. <u>34</u> T. <u>10</u> N R. <u>6</u> E <sup>15F</sup>	<u>sand</u>	<u>80</u>	<u>100</u>
<u>5</u> miles <u>East</u> of <u>Pope</u>	<u>    "    "</u>	<u>100</u>	<u>120</u>
(distance) (direction) (nearest town)	<u>    "    "</u>	<u>120</u>	<u>147</u>

WELL PURPOSE:  
 (home, irrigation, municipal, industrial)

- WELL COMPLETION DATA:
- (1) diameter (inches) 4
  - (2) total depth (feet) 147
  - (3) static water level (feet) 90 below above top of ground.
  - (4) casing PVC 137  
 (material) (depth)
  - 4 if telescope see back.  
 (size)
  - (5) screen 10 137  
 (length) (depth to top)
  - 4 PVC  
 (size) (material)
  - (6) pump 3/4 10  
 (HP) (yield gpm)
  - elec.  
 (type power)
  - (7) electric log no  
 (yes or no)
  - no  
 (organization running log)
  - (8) how well bottom plugged PVC  
plug

CODED

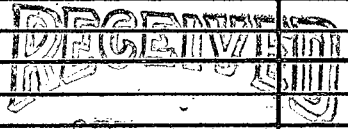

DRILLERS REMARKS:

SEP - 1 1975

