

PANOLA
 WSI
 9-1-77
 E log # 57

MISSISSIPPI
 BOARD OF WATER COMMISSIONERS
 416 North State Street
 Jackson, Mississippi 39201 **CODED**

WATER WELL DRILLERS LOG

Sept 1 1977 Wipe Well & Supply Co. Panola
 date well completed firm name county well located

LANDOWNER:
Love Jay Water Assn.
Panola County Miss
 (mailing address)

WELL LOCATION:
 sec. 13 T. 10 N R. 36 E
10 miles SE of Batesville
 (distance) (direction) (nearest town)

WELL PURPOSE: Water
 (home, irrigation, municipal, industrial)

- WELL COMPLETION DATA:
- (1) diameter (inches) 8 5/8" OD
 - (2) total depth (feet) 420
 - (3) static water level (feet) 187 ^{below} above top of ground.
 - (4) casing Steel 388'
 (material) (depth)
8 5/8" if telescope see back.
 (size)
 - (5) screen 20' 400'
 (length) (depth to top)
6" SS
 (size) (material)
 - (6) pump 15 190
 (HP) (yield gpm)
Electric
 (type power)
 - (7) electric log yes
 (yes or no)
MGS
 (organization running log)
 - (8) how well bottom plugged
Back wash valve

description of formations encountered	from	to
Top soil	0	20
Sand + gravel	20	100
Sand	100	175
Clay	175	210
Sand	210	340
Clay	340	380
Sand	380	435
Shale + Gumbo	435	1000

CODED


RECEIVED
 10 OCT 27 1977

MISS. BD OF WATER COMM

DRILLERS REMARKS:

①
If well telescopes please sketch and show depths.

GROUND LEVEL

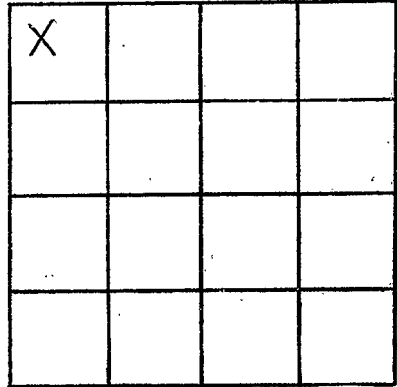

SECTION 13

Please indicate well location X.

ADDITIONAL INFORMATION

If more than one screen, show locations of each on sketch.