

PANOLA  
W-2000  
2-6-76

MISSISSIPPI  
BOARD OF WATER COMMISSIONERS  
416 North State Street  
Jackson, Mississippi 39201

WATER WELL DRILLERS LOG

2-6 15F 1976 Lipe Well Co Panola  
date well completed firm name county well located


LANDOWNER:	description of formations encountered	from	to
Sonny Ford	Top soil	0	20
Pope Miss, (mailing address)	red sand	20	40
	gravel	40	60
	sand and gravel	60	80
	sand	80	100
	sand	100	153
WELL LOCATION:			
sec. 13 T 10 N R 6 E			
8 miles east of Pope			
(distance) (direction) (nearest town)			
WELL PURPOSE:			
(home irrigation, municipal, industrial)			
WELL COMPLETION DATA:			
(1) diameter (inches) 4			
(2) total depth (feet) 153			
(3) static water level (feet) 120 below above top of ground.			
(4) casing PVC 143 (material) (depth)			
4 If telescope see back: (size)			
(5) screen 10 143 (length) (depth to top)			
4 PVC (size) (material)			
(6) pump 3/4 10 (HP) (yield gpm)			
elec. (type power)			
(7) electric log NO (yes or no)			
NO (organization running log)			
(8) how well bottom plugged PVC cap			
DRILLERS REMARKS:			

RECEIVED  
MAR 4 1976

MISS. BD. OF WATER COMM

If well telescopes please sketch and show depths.

GROUND LEVEL

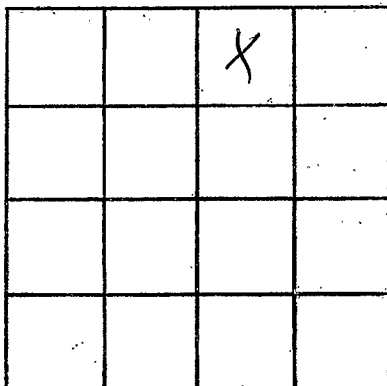

SECTION 13

Please indicate well location X.

ADDITIONAL INFORMATION

If more than one screen, show locations of each on sketch.