

PANOLA
 W-2001
 8/25/76

MISSISSIPPI
 BOARD OF WATER COMMISSIONERS
 416 North State Street
 Jackson, Mississippi 39201

WATER WELL DRILLERS LOG

8-25 1976 Life Well Co. Panola
 date well completed firm name county well located

LANDOWNER:
 U.S. Corps. Engineers
 Enid Lake Ms.
 (mailing address)

description of formations encountered	from	to
TOP Soil	0	20
red sand	20	40
red clay and sand	40	60
sand	60	80
black clay	80	100
" "	100	120
" "	120	140
clay and sand	140	160
white sand	160	183

WELL LOCATION:
 sec. 31 T 10 N R 6 E
 3 miles Southe. POPE
 (distance) (direction) (nearest town)

WELL PURPOSE:
 (home, irrigation, municipal, industrial)

- WELL COMPLETION DATA:
- (1) diameter (inches) 4
 - (2) total depth (feet) 183
 - (3) static water level (feet) 80 below top of ground.
 - (4) casing PVC 173 (material) (depth)
 4 (size) If telescope see back.
 - (5) screen 10 173 (length) (depth to top)
 4 PVC (size) (material)
 - (6) pump 3/4 10 (HP) (yield gpm)
 elec. (type power)
 - (7) electric log NO (yes or no)
 NO (organization running log)
 - (8) how well bottom plugged PVC
 PVC


RECEIVED
 AUG 31 1976

MISS. BD. OF WATER COMM.

DRILLERS REMARKS:

If well telescopes please sketch and show depths.

GROUND LEVEL

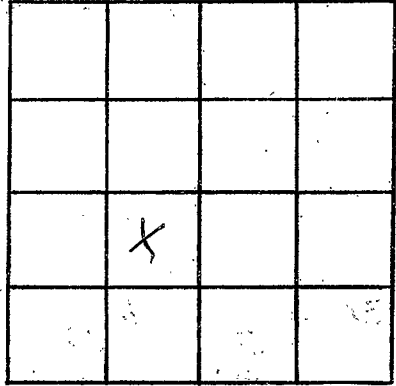

SECTION 31

Please indicate well location X.

ADDITIONAL INFORMATION

If more than one screen,
show locations of each on sketch.