

Panola
 W-2002
 12-7-76

MISSISSIPPI
 BOARD OF WATER COMMISSIONERS
 416 North State Street
 Jackson, Mississippi 39201

WATER WELL DRILLERS LOG

12-7-1976 date well completed
 15F 76 North Miss Well Drilling Panola firm name
 Panola county well located

LANDOWNER: O W Crouch
 Courtland Miss
 (mailing address)

description of formations encountered	from	to
Clay	0	20
Sand	20	90

WELL LOCATION:
 sec. 10 T 10 N R 6 E
 4 miles S-E of Uricka
 (distance) (direction) (nearest town)

WELL PURPOSE: Home
 (home, irrigation, municipal, industrial)

- WELL COMPLETION DATA:
- (1) diameter (inches) 4"
 - (2) total depth (feet) 90
 - (3) static water level (feet) 70 below top of ground.
 - (4) casing Plastic 90
 (material) (depth)
 - (size) If telescope see back.
 - (5) screen 10' 90
 (length) (depth to top)
 4" SLOTT PLASTIC
 (size) (material)
 - (6) pump 1/2 10
 (HP) (yield gpm)
 Elec
 (type power)
 - (7) electric log No
 (yes or no)
 - (organization running log)
 - (8) how well bottom plugged Plug


DRILLERS REMARKS:

RECEIVED
 DEC 21 1976

MISS. BD. OF WATER COMMISSIONERS

If well telescopes please sketch and show depths.

GROUND LEVEL

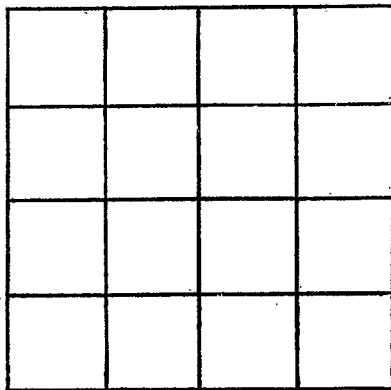

SECTION _____

Please indicate well location X.

ADDITIONAL INFORMATION

If more than one screen, show locations of each on sketch.