

Panola
W-2003
4-12-77

MISSISSIPPI
BOARD OF WATER COMMISSIONERS
416 North State Street
Jackson, Mississippi 39201

WATER WELL DRILLERS LOG

4-12 1977 ^{15F} Lipe well Co. Panola
date well completed firm name county well located

LANDOWNER:
Clyde Mitchell
Batesville Ms.
(mailing address)

description of fomations encountered	from	to
	Top soil	0
Clay	20	40
Sand	40	60
ll	60	100

WELL LOCATION:
sec. 7 T 10 N R 6 E
2.5± miles S. E. of Batesville
(distance) (direction) (nearest town)

WELL PURPOSE:
(home, irrigation, municipal, industrial)

- WELL COMPLETION DATA:
- (1) diameter (inches) 4
 - (2) total depth (feet) 100
 - (3) static water level (feet) 40 below top of ground.
 - (4) casing PVC 90 (material) (depth)
4 (size) If telescope see back.
 - (5) screen 10 90 (length) (depth to top)
4 PVC (size) (material)
 - (6) pump 3/4 10 (HP) (yield.gpm)
elec (type power)
 - (7) electric log NO (yes or no)
NO (organization running log)
 - (8) how well bottom plugged PVC
PVC


RECEIVED
APR 20 1977

DRILLERS REMARKS:

MISS. BD. OF WATER COMMISSIONERS

If well telescopes please sketch and show depths.

GROUND LEVEL

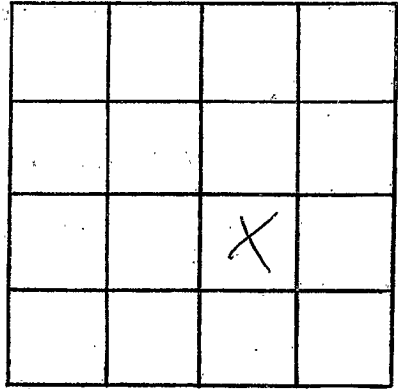

SECTION 7

Please indicate well location X.

ADDITIONAL INFORMATION

If more than one screen, show locations of each on sketch.