

PANOLA
W-2005
4-19-77

MISSISSIPPI
BOARD OF WATER COMMISSIONERS
416 North State Street
Jackson, Mississippi 39201
WATER WELL DRILLERS LOG

4-19

1977 Life Well Co.

Panola

date well completed

firm name

county well located

LANDOWNER:

Gerald R. McKinney

Pope

MS.

(mailing address)

description of formations encountered

from

to

TOP Soil

0

20

red clay and sand

20

40

sand

40

60

clay and sand

60

80

good sand

80

140

WELL LOCATION:

sec. 27 T 10 N R 6 E

5 miles east of Pope

(distance) (direction) (nearest town)

WELL PURPOSE:

(home) irrigation, municipal, industrial

WELL COMPLETION DATA:

- (1) diameter (inches) 4
- (2) total depth (feet) 140
- (3) static water level (feet) 85 below top of ground.
- (4) casing PVC 130 (material) (depth)
- 4 (size) if telescope see back.
- (5) screen 10 130 (length) (depth to top)
- 4 PVC (size) (material)
- (6) pump 3/4 10 (HP) (yield gpm)
- e/c/c (type power)
- (7) electric log N/A (yes or no)
- N/A (organization running log)
- (8) how well bottom plugged PVC CAP

DRILLERS REMARKS:


RECEIVED
JUN 2 1977

MISS. BD. OF WATER COMMISSIONERS

Sec 27 on back

If well telescopes please sketch and show depths.

GROUND LEVEL

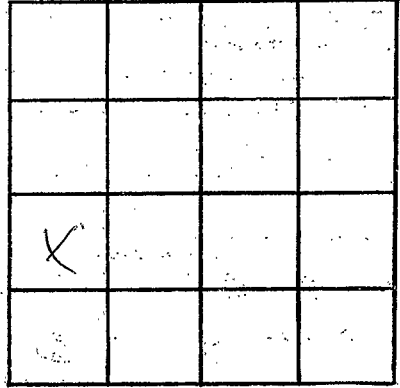

SECTION 27

Please indicate well location X.

ADDITIONAL INFORMATION

If more than one screen, show locations of each on sketch.