

**PANOLA**  
 W-2000  
 6-18-77

MISSISSIPPI  
 BOARD OF WATER COMMISSIONERS  
 416 North State Street  
 15F Jackson, Mississippi 39201

WATER WELL DRILLERS LOG

6-18 date well completed      1977 Lipe Well Co. firm name      Panola county well located

LANDOWNER:	description of formations encountered	from	to
Lipe Well Co.			
Pope MS.	sand	20	80
(mailing address)	clay	80	140
WELL LOCATION:	sand	140	370
sec. 36 T. 27 N. R. 6 E. S. 10	sand	370	420
W 8+ miles east of Pope	clay and sand	420	500
(distance) (direction) (nearest town)	clay	500	540
WELL PURPOSE:	sand	540	625
(home, irrigation, (municipal) industrial)	clay	625	630
WELL COMPLETION DATA:	sand and clay	630	660
(1) diameter (inches) 4	grey Collins Mixed with	660	700
(2) total depth (feet) 795	sand		
(3) static water level (feet) 126 below top of ground.	clay and sand	700	740
(4) casing PVC 688 (material) (depth)	good sand	740	770
4 (size) If telescope see back.		770	795
(5) screen 20 775 (length) (depth to top)			
2" (size) GALV (material)			
(6) pump 1 1/2 20 (HP) (yield gpm)			
elec (type power)			
(7) electric log NON (yes or no)			
NON (organization running log)			
(8) how well bottom plugged steel plug			
DRILLERS REMARKS:			


**RECEIVED**

JUL 8 - 1977

MISSISSIPPI BOARD OF WATER COMMISSIONERS

If well telescopes please sketch and show depths.

GROUND LEVEL

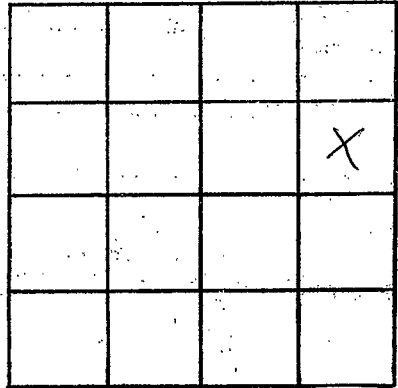

SECTION 3.6

Please indicate well location X.

ADDITIONAL INFORMATION

If more than one screen, show locations of each on sketch.