

PANOLA
W-2007
8-28-80

MISSISSIPPI
BOARD OF WATER COMMISSIONERS
416 North State Street
Jackson, Mississippi 39201

WATER WELL DRILLERS LOG

8-28-1980 date well completed Life Well Co. firm name Panola county well located

LANDOWNER:
Hank Coles
Courtland MS.
(mailing address)

description of formations encountered	from	to
TOP Soil	0	20
red sand	20	40
PINK SAND	40	110

WELL LOCATION:
sec 12 T 10 N R 6 W
8 miles east of Courtland
(distance) (direction) (nearest town)

WELL PURPOSE:
(home, irrigation, municipal, industrial)

- WELL COMPLETION DATA:
- (1) diameter (inches) 4
 - (2) total depth (feet) 110
 - (3) static water level (feet) 60 below top of ground.
 - (4) casing PVC 100 (material) (depth)
4 (size) If telescope see back.
 - (5) screen 10 100 (length) (depth to top)
4 PVC (size) (material)
 - (6) pump 3/4 10 (HP) (yield gpm)
elec. (type power)
 - (7) electric log NO (yes or no)
NO (organization running log)
 - (8) how well bottom plugged PVC Plug

Well OK

DEPT. OF NATURAL RESOURCES
BUREAU OF LAND & WATER RESOURCES


SEP 2 1980

RECEIVED

DRILLERS REMARKS:

If well telescopes please sketch and show depths.

GROUND LEVEL

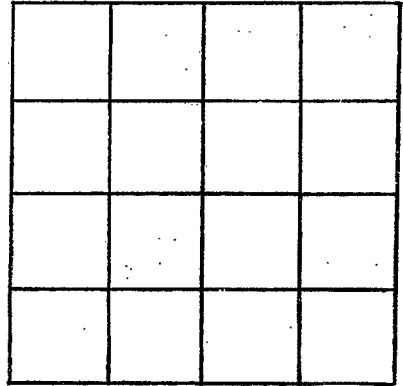

SECTION _____

Please indicate well location X.

ADDITIONAL INFORMATION

If more than one screen,
show locations of each on sketch.