

PANOLA
 W-2008
 8-28-80

MISSISSIPPI
 BOARD OF WATER COMMISSIONERS
 416 North State Street
 Jackson, Mississippi 39201

WATER WELL DRILLERS LOG

8-28 1980 Lipc Well Co. Panola
 date well completed firm name county well located

LANDOWNER:
 Hank Coles
 Courtland MS.
 (mailing address)

description of formations encountered	from	to
Top soil	0	20
red sand	20	40
white clay and sand	40	60
white sand	60	110

WELL LOCATION:
 sec. 12 T. 10 N R. 6 E
 10 miles east of Courtland
 (distance) (direction) (nearest town)

WELL PURPOSE:
 (home irrigation, municipal, industrial)


- WELL COMPLETION DATA:
- diameter (inches) 4"
 - total depth (feet) 110
 - static water level (feet) 60' below top of ground.
 - casing PVC 100' (material) (depth)
 4 (size) if telescope see back.
 - screen 10 100' (length) (depth to top)
 4 PVC (size) (material)
 - pump 3/4 10 (HP) (yield gpm)
 elec. (type power)
 - electric log NO (yes or no)
 NOVC (organization running log)
 - how well bottom plugged PVC cap

DEPT. OF NATURAL RESOURCES
 BUREAU OF LAND & WATER RESOURCES
 OCT 16 1980
 RECEIVED

DRILLERS REMARKS:

If well telescopes please sketch and show depths.

GROUND LEVEL

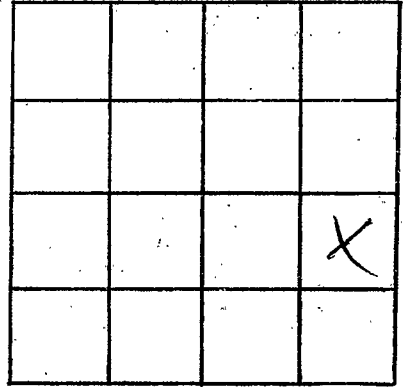

SECTION 12

Please indicate well location X.

ADDITIONAL INFORMATION

If more than one screen,
show locations of each on sketch.