

MISSISSIPPI DEPARTMENT OF NATURAL RESOURCES

Bureau of Land and Water Resources

Southport Mall

P.O. Box 10631

Jackson, Mississippi 39209

WATER WELL DRILLERS LOG

PANOLA
W-2009
3-13-81

March 13 1981 date well completed *Life Well Supply Co Inc Panola* firm name *panola* county well located

LANDOWNER: *Maurice Juremen*
Batesville
 (mailing address)

WELL LOCATION:
 sec *33* T *10* N R *6* E
 (distance) miles of (direction) (nearest town)

WELL PURPOSE:
 (home, irrigation, municipal, industrial)

WELL COMPLETION DATA:

(1) diameter (inches) *4"*

(2) total depth (feet) *92 ft*

(3) static water level (feet) *60* below above top of ground.

(4) casing *PVC* *92*
 (material) (depth)
4 if telescope see back.
 (size)

(5) screen *8 ft* *94 ft*
 (length) (depth to top)
 (size) (material)

(6) pump *1/2* *10*
 (HP) (yield gpm)
 (type power)

(7) electric log (yes or no)

(organization running log)

(8) how well bottom plugged *cap*

description of formations encountered	from	to
CLAY	0	10
SAND	10	20
YELLOW SAND	20	40
YELLOW SAND	40	60
YELLOW SAND	60	80
YELLOW SAND	80	89
rock	89	
blue clay	89	94

DRILLERS REMARKS:


DEPT. OF NATURAL RESOURCES
 BUREAU OF LAND & WATER RESOURCES

MAY - 5 1981

RECEIVED

If well telescopes please sketch and show depths.

GROUND LEVEL

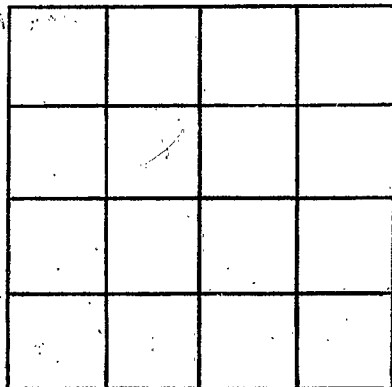

SECTION _____

Please indicate well location X.

ADDITIONAL INFORMATION

If more than one screen, show locations of each on sketch.