

XX
5-3-65

WATER WELL DRILLERS LOG

Date: 5.31, 1965, Driller: ²¹⁸²Frank Zylo County Panola
(Name)


(1) Owner of Land:	Description & Color of Materials Sand, Clay, Red Clay, Shell, etc.	Thick- ness Feet	Depth Feet
<u>To Lie Morgan</u> (Name) <u>Pope R. 1</u> (Address)	<u>Top Soil</u>	<u>0</u>	<u>20</u>
	<u>Red Sand</u>	<u>20</u>	<u>40</u>
	<u>White clay-sand</u>	<u>40</u>	<u>60</u>
(2) Location: <u>1/4</u> , <u>1/4</u> , Sec. <u>9</u> T <u>10</u> R <u>6</u> W <u>1</u> <u>10</u> miles <u>east</u> , of <u>Pope</u> (distance) (direction) (Nearest Town)	<u>Clay and sand</u>	<u>80</u>	<u>100</u>
	<u>Black Clay</u>	<u>100</u>	<u>126</u>
(3) Topography: <u>Hills</u> (Hilly) (Flat) (Level)	<u>water sand</u>	<u>126</u>	<u>138</u>
(4) Purpose of Well: <u>Domestic</u> (Domestic Irrigation Municipal, Industrial, Other)			

Information upon completion of well:

- (1) Diameter 2 inches.
- (2) Total Depth 138 feet.
- (3) Water Level _____ feet below top of ground.
- (4) Cased to 127, Size 2
- (5) Screen: Size 1/4, Length 6
- (6) Were any formations sealed against pollution?
_____ yes, _____ no.

If YES depth of formation _____
Why _____

Drillers Remarks: _____

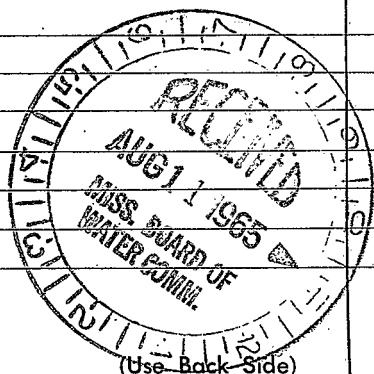

Well No. _____

