

PANOLA
X 4
16-21-74


MISSISSIPPI
BOARD OF WATER COMMISSIONERS
416 North State Street
Jackson, Mississippi 39201

CODHD

WATER WELL DRILLERS LOG

10-21-1974 date well completed
LIFE Well CO. firm name
Panola county well located


LANDOWNER:	description of formations encountered	from	to
Julius Washington Water Valley Miss. (mailing address)			
WELL LOCATION: sec. 8 T 10 N R 5 E 8 miles West of Water Valley (distance) (direction) (nearest town)			
WELL PURPOSE: (home, irrigation, municipal, industrial)			
WELL COMPLETION DATA:			
(1) diameter (inches) 4			
(2) total depth (feet) 102			
(3) static water level (feet) 60 below top of ground.			
(4) casing PVC 9.2 (material) (depth)			
4 If telescope see back. (size)			
(5) screen 10 9.2 (length) (depth to top)			
4 PVC (size) (material)			
(6) pump 3/4 10 (HP) (yield gpm)			
elec. (type power)			
(7) electric log NO (yes or no)			
NO (organization running log)			
(8) how well bottom plugged PVC CAP			
DRILLERS REMARKS:			

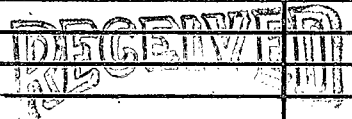

NOV - 4 1974

If well telescopes please sketch and show depths.

GROUND LEVEL

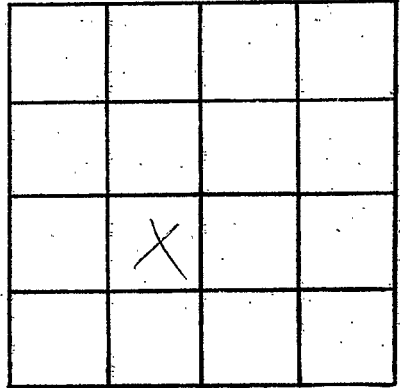

SECTION 8

Please indicate well location X.

ADDITIONAL INFORMATION

If more than one screen, show locations of each on sketch.