

PANOLA  
X 5  
9-6-74

MISSISSIPPI  
BOARD OF WATER COMMISSIONERS  
416 North State Street  
Jackson, Mississippi 39201

CODED

WATER WELL DRILLERS LOG

9-6-74 date well completed      W.B. Mason firm name      Panola county well located

LANDOWNER:  
Leslie Woodard  
RFD, Water Valley Miss  
(mailing address)

description of formations encountered	from	to
Clay Lint	0	6
Red sand	6	54
blue clay	at	54

WELL LOCATION:  
sec. 8 T 10 N R 5 E  
6 miles North of Water Valley  
(distance) (direction) (nearest town)

WELL PURPOSE:  
(home, irrigation, municipal, industrial)

WELL COMPLETION DATA:

(1) diameter (inches) 4"

(2) total depth (feet) 54'

(3) static water level (feet) 36' below top of ground.

(4) casing Plastic, 44' (material) (depth)  
4" (size) if telescope see back.

(5) screen 10' 44' (length) (depth to top)  
4" Plastic (size) (material)

(6) pump 1/3 5 (HP) (yield gpm)  
electric (type power)

(7) electric log No (yes or no)

(organization running log)

(8) how well bottom plugged Cap

CODED


RECEIVED  
DEC 27 1974

MISS. BD. OF WATER COMMISSIONERS

DRILLERS REMARKS:

If well telescopes please sketch and show depths.

GROUND LEVEL

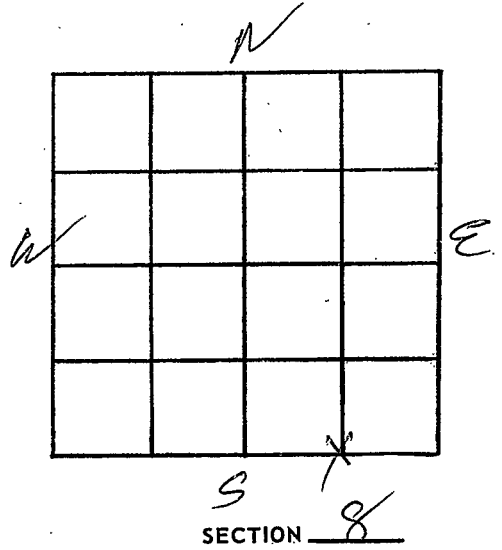

Please indicate well location X.

ADDITIONAL INFORMATION

If more than one screen, show locations of each on sketch.