

PANOLA  
X6  
8-10-74

MISSISSIPPI  
 BOARD OF WATER COMMISSIONERS  
 416 North State Street  
 Jackson, Mississippi 39201

WATER WELL DRILLERS LOG

8-10-1974 date well completed      W.C. Mason firm name      Panola county well located

**LANDOWNER:**  
 Joe Harper  
 Memphis Tenn.  
 (mailing address)

**WELL LOCATION:**  
 sec. 8 T. 10 N. R. 5 E.  
 6 miles East of Gretna  
 (distance) (direction) (nearest town)

**WELL PURPOSE:** Home  
 (home, irrigation, municipal, industrial)

**WELL COMPLETION DATA:**  
 (1) diameter (inches) 4"  
 (2) total depth (feet) 90'  
 (3) static water level (feet) 36' below top of ground.  
 (4) casing Plastic 80' (material) (depth)  
 4" (size) if telescope see back.  
 (5) screen 10' 80' (length) (depth to top)  
 4" Plastic (size) (material)  
 (6) pump 1/2 10 (HP) (yield gpm)  
 electric (type power)  
 (7) electric log No (yes or no)  
 (organization running log)  
 (8) how well bottom plugged cap

description of formations encountered	from	to
clay silt	90	10
Black clay	10	18
Rock	18	38
Red sand	38	54
Rock	54	55
chert sand	55	90


CODED

RECEIVED  
 DEC 27 1974

DRILLERS REMARKS: MISS. BD. OF WATER COMMISSIONERS

If well telescopes please sketch and show depths.

GROUND LEVEL

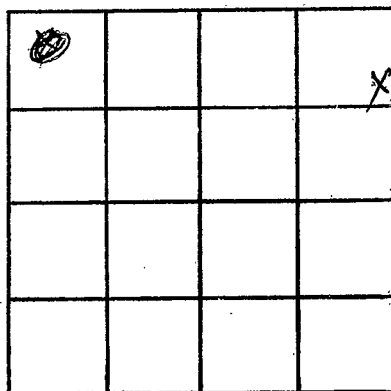

SECTION 8

Please indicate well location X.

ADDITIONAL INFORMATION

If more than one screen, show locations of each on sketch.