

Panola  
X 7  
6-23-75

MISSISSIPPI  
 BOARD OF WATER COMMISSIONERS  
 416 North State Street  
 Jackson, Mississippi 39201

CODED

WATER WELL DRILLERS LOG

June 23 1975 North Miss Well Drilling Panola  
 date well completed firm name county well located

LANDOWNER	description of formations encountered	from	to
<u>Charley Barnes</u> <u>Water Valley</u>			
(mailing address)	<u>Sand</u>	<u>10</u>	<u>113</u>

WELL LOCATION:  
 sec. 5 T. 10 N. R. 5 E. 15F  
 S. L. W. L.  
6 miles N-W of Water Valley  
 (distance) (direction) (nearest town)

WELL PURPOSE: Home  
 (home, irrigation, municipal, industrial)

- WELL COMPLETION DATA:
- (1) diameter (inches) 4"
  - (2) total depth (feet) 113
  - (3) static water level (feet) 60 below top of ground.
  - (4) casing 4 Plastic 113  
 (material) (depth)
  - (size) If telescope see back.
  - (5) screen 10' 103  
 (length) (depth to top)
  - (size) 4 Plastic  
 (material)
  - (6) pump 3/4 15  
 (HP) (yield gpm)
  - Elec  
 (type power)
  - (7) electric log No  
 (yes or no)

(organization running log)


(8) how well bottom plugged Plug

DRILLERS REMARKS:

RECEIVED  
 JUL 14 1975

If well telescopes please sketch and show depths.

GROUND LEVEL

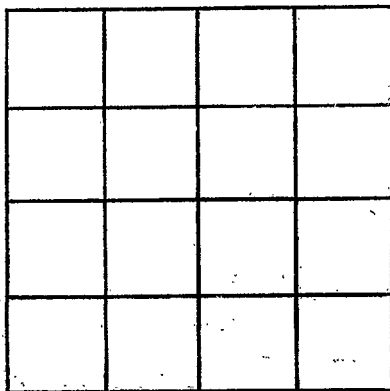

SECTION \_\_\_\_\_

Please indicate well location X.

ADDITIONAL INFORMATION

If more than one screen, show locations of each on sketch.