

Panola
 X-2000
 5/23/60

MISSISSIPPI
 BOARD OF WATER COMMISSIONERS
 416 North State Street
 Jackson, Mississippi 39201

WATER WELL DRILLERS LOG

5-9 19 80 Lipe Well Co. Panola
 date well completed firm name county well located

LANDOWNER: Jim Inzer
 Oxford MS.
 (mailing address)

description of formations encountered
 TOP soil from 8 to 20
 red sand 20 to 40
 " " 40 to 80
 " " 80 to 160

WELL LOCATION:
 sec. 33 T 27 N R 5 E
 10 S (W)
 10 miles East of Pope
 (distance) (direction) (nearest town)

WELL PURPOSE:
 (home) irrigation, municipal, industrial

- WELL COMPLETION DATA:
- (1) diameter (inches) 4
 - (2) total depth (feet) 160
 - (3) static water level (feet) 114 below top of ground.
 - (4) casing PVC 148 (material) (depth)
 4 (size) if telescope see back.
 - (5) screen 12 148 (length) (depth to top)
 4 PVC (size) (material)
 - (6) pump 3/4 10 (HP) (yield gpm)
 elec. (type power)
 - (7) electric log NO (yes or no)
 NON (organization running log)
 - (8) how well bottom plugged PVC CAP

DEPT. OF NATURAL RESOURCES
 BUREAU OF LAND & WATER RESOURCES


MAY 19 1960

DRILLERS REMARKS:
 From 80' to 160 no return on drilling fluid

RECEIVED

If well telescopes please sketch and show depths.

GROUND LEVEL

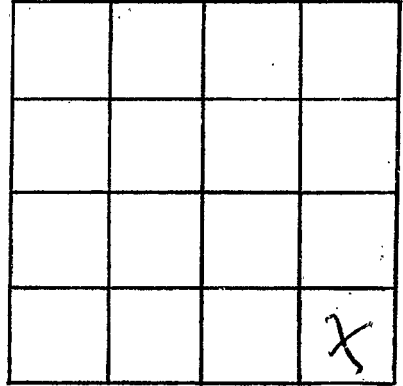

SECTION 33

Please indicate well location X.

ADDITIONAL INFORMATION

If more than one screen,
show locations of each on sketch.