

Panel
X
2001

MISSISSIPPI
 BOARD OF WATER COMMISSIONERS
 416 North State Street
 Jackson, Mississippi 39201

WATER WELL DRILLERS LOG

4/20/84 19 Lipe Well Supply Panel
 date well completed firm name county well located

LANDOWNER: <u>Frank Blown</u>	description of formations encountered	from	to
<u>R4 Box 156</u> <u>Oxford MS</u> (mailing address)			
WELL LOCATION:			
sec <u>4</u> T <u>10</u> N R <u>5</u> E <u>11</u> miles <u>E</u> of <u>Oxford</u> (distance) (direction) (nearest town)			
WELL PURPOSE: (home, irrigation, municipal, industrial)			
WELL COMPLETION DATA:			
(1) diameter (inches) <u>4</u>			
(2) total depth (feet) <u>120</u>			
(3) static water level (feet) <u>55</u> ^{below} _{above} top of ground.			
(4) casing <u>PVC</u> <u>110</u> (material) (depth)			
<u>4</u> (size) if telescope see back.			
(5) screen <u>10</u> <u>110</u> (length) (depth to top)			
<u>4</u> <u>PVC</u> (size) (material)			
(6) pump <u>1/2</u> <u>10</u> (HP) (yield gpm)			
<u>ele</u> (type power)			
(7) electric log <u>(yes or no)</u>			
(organization running log)			
(8) how well bottom plugged <u>PVC</u> <u>Seal</u>			
DRILLERS REMARKS:			


MISSISSIPPI
 DEPT. OF NATURAL RESOURCES
 BUREAU OF LAND & WATER RESOURCES

APR 23 1984

RECEIVED

well telescopes please
sketch and show depths.

GROUND LEVEL

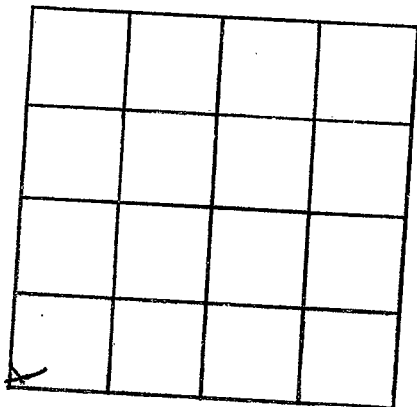

SECTION 4

Please indicate well location X.

ADDITIONAL INFORMATION

If more than one screen,
show locations of each on sketch.