

MISSISSIPPI DEPARTMENT OF NATURAL RESOURCES

Bureau of Land and Water Resources

Southport Mall

P.O. Box 10631

Jackson, Mississippi 39209

WATER WELL DRILLERS LOG

Panola

Panola
X
2002

5-6 1991 LIFE Well & Supply Co. Inc.
date well completed firm name county well located

LANDOWNER: <u>Lloyd Bishop</u> <u>Rt. 1 Box 363</u>	description of formations encountered	from	to
<u>Water Valley, Ms. 38965</u> (mailing address)			
WELL LOCATION: sect. <u>17</u> T. <u>10</u> N. R. <u>5</u> E. <u>15</u> miles <u>SE</u> of <u>Bolesville</u> (distance) (direction) (nearest town)	<u>Top soil, red sand, shell rock</u>	<u>0</u>	<u>20</u>
	<u>sand with streak of clay</u>	<u>20</u>	<u>40</u>
	<u>sand-shell rock-sand-rock-sand</u>	<u>40</u>	<u>60</u>
	<u>sand with streaks of clay-clay</u>	<u>60</u>	<u>80</u>
	<u>clay with streaks of sand</u>	<u>80</u>	<u>100</u>
	<u>clay with streak of sand-clay-sand</u>	<u>100</u>	<u>120</u>
	<u>clay + sand mixed streaks of sand</u>	<u>120</u>	<u>140</u>
	<u>clay with streaks of sand</u>	<u>140</u>	<u>160</u>
WELL PURPOSE: <u>Home</u> (home, irrigation, municipal, industrial)	<u>little clay at top then sand</u>	<u>160</u>	<u>180</u>

WELL COMPLETION DATA:

(1) diameter (inches) 4"

(2) total depth (feet) 180

(3) static water level (feet) _____ below above top of ground.

(4) casing PVC, 160
(material) (depth)
4 if telescope see back.
(size)

(5) screen 10, 160
(length) (depth to top)
4, PVC
(size) (material)

(6) pump 3/4
(HP) (yield gpm)
(type power)

(7) electric log no
(yes or no)
(organization running log)

(8) how well bottom plugged capped


RECEIVED
JUN 28 1991

Dept. of Environmental Quality
Bureau of Land & Water Resources

DRILLERS REMARKS: _____

If well telescopes please sketch and show depths.

GROUND LEVEL

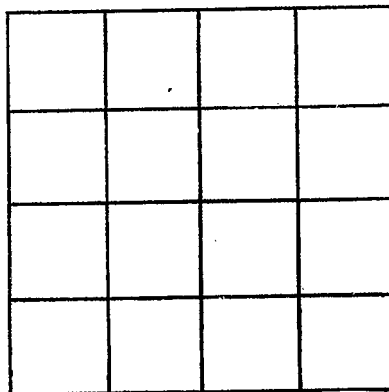

SECTION _____

Please indicate well location X.

ADDITIONAL INFORMATION

If more than one screen,
show locations of each on sketch.