

PEARL RIVER

A2

1-9-71

MISSISSIPPI BOARD OF WATER COMMISSIONERS  
416 North State Street  
Jackson, Mississippi 39201

**CODED**

WATER WELL DRILLERS LOG

1-9  
date well completed

1971 *McArthur Water Well Drilling Pearl River*  
firm name county well located

LANDOWNER: *Charles S. Temple*  
*Rt #1 Poplarville*  
*Miss*  
(mailing address)

| description of formations encountered | from      | to        |
|---------------------------------------|-----------|-----------|
| <i>Clay</i>                           | <i>0</i>  | <i>45</i> |
| <i>Fine Sand</i>                      | <i>45</i> | <i>65</i> |
| <i>Coarse Sand</i>                    | <i>65</i> | <i>96</i> |

WELL LOCATION:  
sec. *2* T. *1* S. R. *17* W.  
*15* miles *NE* of *Cross Road*  
(distance) (direction) (nearest town)

WELL PURPOSE:  
(home, irrigation, municipal, industrial)

- WELL COMPLETION DATA:
- (1) diameter (inches) *4"*
  - (2) total depth (feet) *96'*
  - (3) static water level (feet) *65* below above top of ground.
  - (4) casing *PVC* *96'*  
(material) (depth)  
(size) if telescope see back.
  - (5) screen *10'* *86'*  
(length) (depth to top)  
*4"* *PVC*  
(size) (material)
  - (6) pump *1/2* *15*  
(HP) (yield gpm)  
*Electric*  
(type power)
  - (7) electric log *no*  
(yes or no)
  - (organization running log)
  - (8) how well bottom plugged *Back*  
*pressure valve*

**CODED**


NOV 1 1971

BAS  
MAY 11 1971

DRILLERS REMARKS:

If well telescopes please sketch and show depths.

GROUND LEVEL

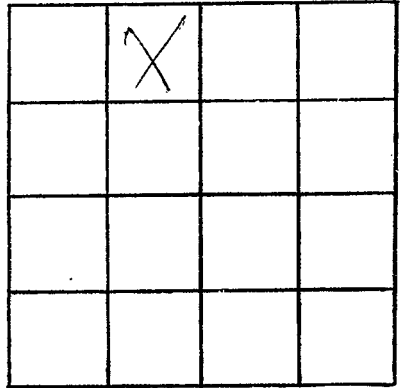

SECTION 15

Please indicate well location X.

ADDITIONAL INFORMATION

If more than one screen, show locations of each on sketch.