

Pearl River
A.3
1-21-72

MISSISSIPPI
 BOARD OF WATER COMMISSIONERS
 416 North State Street
 Jackson, Mississippi 39201

CODED

WATER WELL DRILLERS LOG

1-21 1972 Bud Linton & Son Pearl River
 date well completed firm name county well located

LANDOWNER: Eddie Ard
Poplarville, Miss.
 (mailing address)

description of formations encountered	from	to
<u>Red Shale</u>	<u>0</u>	<u>12</u>
<u>Red sand</u>	<u>12</u>	<u>30</u>
<u>White Shale</u>	<u>30</u>	<u>55</u>
<u>White sand</u>	<u>55</u>	<u>150</u>
<u>Blue Shale</u>	<u>150</u>	<u>175</u>
<u>White sand</u>	<u>175</u>	<u>210</u>

WELL LOCATION:
 sec. 4 T. 1 N. R. 17 E.
12 miles W of Poplarville
 (distance) (direction) (nearest town)

WELL PURPOSE: Home
 (home, irrigation, municipal, industrial)

WELL COMPLETION DATA:

(1) diameter (inches) 4 in

(2) total depth (feet) 210

(3) static water level (feet) 151 ^{below} ~~above~~ top of ground.

(4) casing PVC 200
 (material) (depth)

(size) if telescope see back.

(5) screen 10 200
 (length) (depth to top)

4x10, PVC no 10
 (size) (material)

(6) pump 1 650
 (HP) (yield gpm)

electric
 (type power)

(7) electric log NO
 (yes or no)

(organization running log)

CODED

JAN 31 1972


(8) how well bottom plugged and stuck

MISS. Bd. OF
 WATER COM.

DRILLERS REMARKS:

If well telescopes please sketch and show depths.

GROUND LEVEL

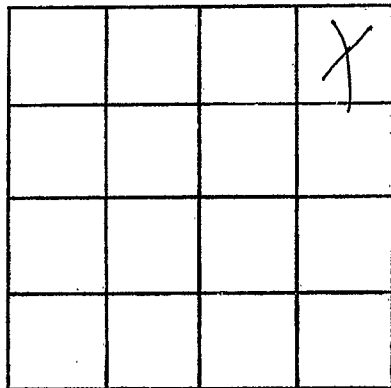

SECTION _____

Please indicate well location X.

ADDITIONAL INFORMATION

If more than one screen,
show locations of each on sketch.