

Pearl River  
A5  
11-28-73

MISSISSIPPI  
BOARD OF WATER COMMISSIONERS  
416 North State Street  
Jackson, Mississippi 39201

CODED

WATER WELL DRILLERS LOG

11-28 1973 Sumph Well Ser. Paul Limer  
date well completed firm name county well located

LANDOWNER: ~~XXXXXXXXXXXXXXXXXXXX~~  
Mr. S. E. Bunge  
Paplarville, Miss  
(mailing address)

description of formations encountered	from	to
Clay	0	12
Sand	12	20
Clay	20	50
Fine Sand	50	75
Clay	75	120
Sand	120	155

WELL LOCATION:  
sec. 22 T 1 N R 17 E  
9 miles N.W. of Paplarville  
(distance) (direction) (nearest town)

WELL PURPOSE: Home  
(home, irrigation, municipal, industrial)

WELL COMPLETION DATA:

(1) diameter (inches) 4"

(2) total depth (feet) 155

(3) static water level (feet) 32 below top of ground.

(4) casing P.V.C., 145'  
(material) (depth)  
4" If telescope see back.  
(size)

(5) screen 10', 145'  
(length) (depth to top)  
4", P.V.C.  
(size) (material)

(6) pump 1/2 Sub, 800 P.h.  
(HP) (yield gpm)  
Elec.  
(type power)

(7) electric log No.  
(yes or no)

(organization running log)

(8) how well bottom plugged Sand hole

CODED

6 1/2  
1 1/2  
3 1/2


DRILLERS REMARKS:

NOV 29 1973

MISS. B.  
WATER C.

If well telescopes please sketch and show depths.

GROUND LEVEL

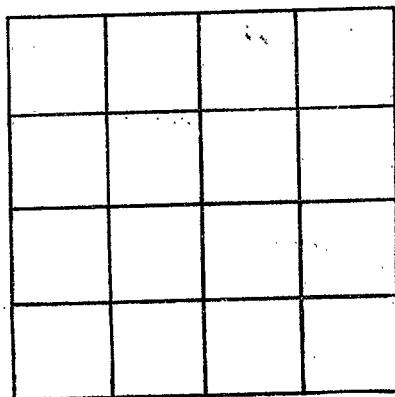

SECTION \_\_\_\_\_

Please indicate well location X.

ADDITIONAL INFORMATION

If more than one screen,  
show locations of each on sketch.