

Pearl R.
A6
3-20-75

MISSISSIPPI
BOARD OF WATER COMMISSIONERS
416 North State Street
Jackson, Mississippi 39201

COL

WATER WELL DRILLERS LOG

3-20-
date well completed

1975 Lumber Well Inc.
firm name


Pearl River
county well located

LANDOWNER:	description of formations encountered	from	to
<u>Mr. & Mrs. F.B. Hayne</u>			
<u>Rt. Poplarville, Miss</u>	<u>Clay</u>	<u>0</u>	<u>240</u>
(mailing address)	<u>Sand</u>	<u>240</u>	<u>301</u>
WELL LOCATION:			
sec. <u>24</u> T. <u>N</u> R. <u>17</u> E			
<u>11</u> miles <u>N.W.</u> of <u>Poplarville</u>			
(distance) (direction) (nearest town)			
WELL PURPOSE: <u>Home</u>			
(home, irrigation, municipal, industrial)			
WELL COMPLETION DATA:			
(1) diameter (inches) <u>2"</u>			
(2) total depth (feet) <u>301</u>			
(3) static water level (feet) <u>130</u> below top of ground.			
(4) casing <u>Gal.</u> , <u>29.5'</u>			
(material) (depth)			
<u>2"</u> If telescope see back.			
(size)			
(5) screen <u>6'</u> , <u>29.5'</u>			
(length) (depth to top)			
<u>2"</u> , <u>Gal. Steel</u>			
(size) (material)			
(6) pump <u>1</u> , <u>29.5 H.P.</u>			
(HP) (yield gpm)			
<u>Elec.</u>			
(type power)			
(7) electric log <u>No</u>			
(yes or no)			
(organization running log)			
(8) how well bottom plugged <u>Sand & Shale</u>			
DRILLERS REMARKS:			

MAR 25 1975
MISS. BD. OF WATER COMMISSIONERS

If well telescopes please
sketch and show depths.

GROUND LEVEL

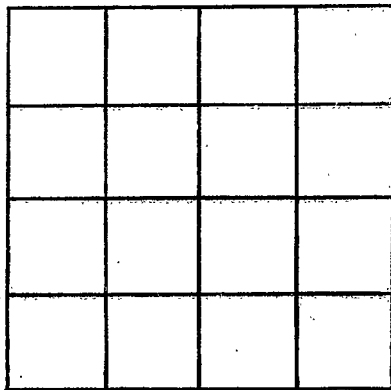

SECTION _____

Please indicate well location X.

ADDITIONAL INFORMATION

If more than one screen,
show locations of each on sketch.