

Pearl River
A-7
12-21-79

MISSISSIPPI
BOARD OF WATER COMMISSIONERS
416 North State Street
Jackson, Mississippi 39201

WATER WELL DRILLERS LOG

12-21 1979 Griner Drilling Pearl River

date well completed

firm name

county well located

LANDOWNER:

R. E. Williams
P.O. Box 698
Natchez, Ms.
(mailing address)

description of formations encountered

from to

Clay	0	182
sand	182	287
sand + gravel	287	357

WELL LOCATION: 1785 S + 1567 E

No. 1-11
Sou. Mineral
T 1 N R 17 E of NW 1/4

0 miles (distance) of (direction) of (nearest town)

WELL PURPOSE:
(home, irrigation, municipal, industrial)

WELL COMPLETION DATA:

- (1) diameter (inches) 3"
- (2) total depth (feet) 371'
- (3) static water level (feet) 75' below top of ground.
- (4) casing steel 357' (material) (depth)
3" (size) if telescope see back.
- (5) screen 42 315' (length) (depth to top)
3" perforated (size) (material)
- (6) pump 70 (HP) (yield gpm)
AC (type power)
- (7) electric log (yes or no)
- (organization running log)

(8) how well bottom plugged peel orange

DRILLERS REMARKS:


DEPT. OF NATURAL RESOURCES
BUREAU OF LAND & WATER RESOURCES

JAN 9 1980

RECEIVED

If well telescopes please sketch and show depths.

GROUND LEVEL

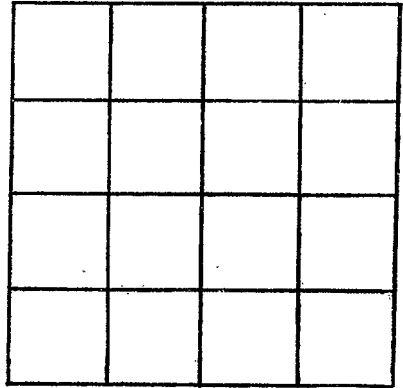

SECTION _____

Please indicate well location X.

ADDITIONAL INFORMATION

If more than one screen, show locations of each on sketch.