

MISSISSIPPI DEPARTMENT OF NATURAL RESOURCES

Bureau of Land and Water Resources  
 WATER WELL SERVICE  
 ROUTE 3 BOX 41  
 CARRIER, MS 39460. Box 10631  
 PHONE 798-5324  
 Jackson, Mississippi 39209

WATER WELL DRILLERS LOG

CODED

Pearl River  
 A 8  
 9-1-81

9/1 1981  
 date well completed

firm name

*Pearl River*  
 county well located

LANDOWNER: *E B Williams*

description of formations encountered

from to

*Poplarville Miss.*

<i>Red Shale</i>	<i>0</i>	<i>12</i>
<i>White Sand</i>	<i>12</i>	<i>40</i>
<i>Blue Shale</i>	<i>60</i>	<i>350</i>
<i>Grey Sand</i>	<i>350</i>	<i>400</i>

(mailing address)

WELL LOCATION:

sec. 32 T 1 N R. 17 E  
 (distance) miles 16 (direction) NW of Poplarville (nearest town)

WELL PURPOSE: home  
 (home, irrigation, municipal, industrial)

WELL COMPLETION DATA:

- (1) diameter (inches) 4"
- (2) total depth (feet) 400
- (3) static water level (feet) 8 below/above top of ground.
- (4) casing PVC / 400  
 (material) (depth)  
no if telescope see back.  
 (size)
- (5) screen 4x20 / 380  
 (length) (depth to top)  
10 / PVC  
 (size) (material)
- (6) pump no / 3400  
 (HP) (yield gpm)  
no  
 (type power)
- (7) electric log no  
 (yes or no)

CODED

(organization running log)

(8) how well bottom plugged hard

DRILLERS REMARKS:


DEPT. OF NATURAL RESOURCES  
 BUREAU OF LAND & WATER RESOURCES

SEP 29 1981

RECEIVED

If well telescopes please sketch and show depths.

GROUND LEVEL

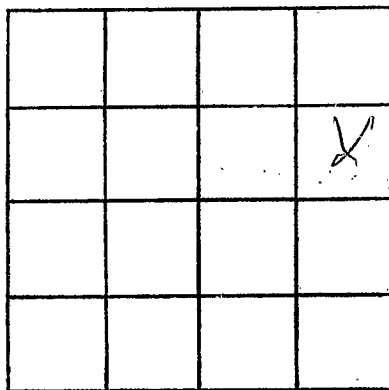

SECTION \_\_\_\_\_

Please indicate well location X.

ADDITIONAL INFORMATION

If more than one screen,  
show locations of each on sketch.