

MISSISSIPPI DEPARTMENT OF NATURAL RESOURCES

Bureau of Land and Water Resources

Southport Mall

P.O. Box 10631

CODED

Jackson, Mississippi 39209

WATER WELL DRILLERS LOG

Pearl River
A9
7/12/82

BUD PENTON & SON
WATER WELL SERVICE
ROUTE 11 BOX 100
CARRIAGE WIS. 39426
PHONE 738-3324

Pearl River
county well located

7/12 1982
date well completed

LANDOWNER: D. D. Newton
R. T. H Poplarville
Mesa
(mailing address)

| description of formations encountered | from | to |
|---------------------------------------|------|-----|
| Red shale | 0 | 20 |
| Red sand | 20 | 63 |
| White shale | 63 | 252 |
| Gray sand | 252 | 420 |
| Blue shale | 420 | 475 |
| Sand rock | 475 | 501 |

WELL LOCATION:
sec 36 T-1 N R-17 E
19 miles SW of Poplarville
(distance) (direction) (nearest town)

WELL PURPOSE: farm
(home, irrigation, municipal, industrial)

- WELL COMPLETION DATA:
- (1) diameter (inches) 4"
 - (2) total depth (feet) 501
 - (3) static water level (feet) 78 below above top of ground.
 - (4) casing pvc, 501 (material) (depth)
no (size) if telescope see back.
 - (5) screen 4x20, 481 (length) (depth to top)
12 (size) pvc (material)
 - (6) pump 5 (HP) 60 (yield gpm)
Elect (type power)
 - (7) electric log no (yes or no)

(8) how well bottom plugged hard
shard

DRILLERS REMARKS:


DEPT. OF NATURAL RESOURCES
BUREAU OF LAND & WATER RESOURCES

SEP - 1 1982

RECEIVED

If well telescopes please
sketch and show depths.

GROUND LEVEL

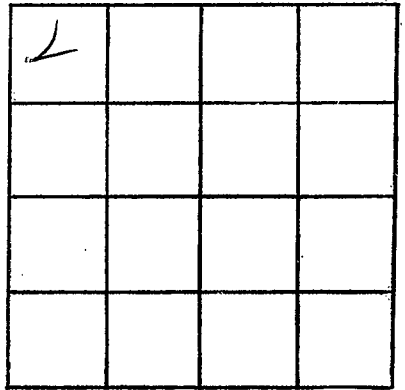

SECTION _____

Please indicate well location X.

ADDITIONAL INFORMATION

If more than one screen,
show locations of each on sketch.