

MISSISSIPPI DEPARTMENT OF NATURAL RESOURCES

Bureau of Land and Water Resources

Southport Mall

P.O. Box 10631

Jackson, Mississippi 39209

CODED

WATER WELL DRILLERS LOG

Griner Drilling Service, Inc.

Pearl River

PEARL RIVER
A 16
8/30/84

8-30-84

date well completed

firm name

county well located

LANDOWNER:

Santa Fe Energy Co.
One Security Park
7200 I 40 West
Amarillo, TX. 79106
(mailing address)

description of formations encountered

from

to

Fill

0

20

clay

20

106

sand, pea gravel

106

420

WELL LOCATION: 1500' N + 1750' E

sq. 16 1 N R. 17 E of
No. of Poplarville, Miss. Hunt's Hill
School District (direction) of (nearest town)

WELL PURPOSE: oilfield supply
(home, irrigation, municipal, industrial)

WELL COMPLETION DATA:

- (1) diameter (inches) 4"
- (2) total depth (feet) 420'
- (3) static water level (feet) 70-80' below
top of ground.
- (4) casing steel 420'
(material) (depth)
4"
(size) if telescope see back.
- (5) screen 42' 378'
(length) (depth to top)
4" perforated
(size) (material)
- (6) pump — 100
(HP) (yield gpm)
AC
(type power)
- (7) electric log (yes or no)

CODED

(organization running log)

- (8) how well bottom plugged orange peel

DRILLERS REMARKS:


DEPT. OF NATURAL RESOURCES
BUREAU OF LAND & WATER RESOURCES

SEP -7 1984

RECEIVED

If well telescopes please
sketch and show depths.

GROUND LEVEL

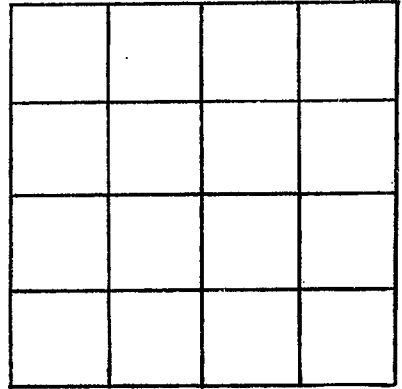

SECTION _____

Please indicate well location X.

ADDITIONAL INFORMATION

If more than one screen,
show locations of each on sketch.