
	STATE	WELL REPORT	<u> </u>	
County: <u>pear 1 River</u> Permit #: Driller: <u>Josh Boone</u> Date drilling completed: <u>8-27-18</u>	Part 1 Driller's Log Mississippi Department of Environmental Quality Office of Land and Water Resources P.O. Box 2309 Jackson, MS 39225-2309 (601)961-5555 (601)961-5228 (fax)		For Office Use Only: Well #:	
State Law requires that this report be prepared by the license holder responsible for the work and filed with the Department at the above address within 30 days of completion of drilling of the well or borehole.				
Well Owner Informatic (Landowner if borehole is not for a Owner Name: <u>A StevenS</u> Mailing Address: <u>10338</u> Hwy <u>poplar on the MS</u> City State	43 N	Latitude: <u>30 58 5</u> Lor Method of Lat/Long (<i>check one</i> USGS quad, Hand-held G): Conventional Survey,	
City State Telephone No. (<u>985</u>) .516 - <u>4736</u>	Zip Code	<u> 4</u> Miles <u></u> (Distance) (Direction)	f <u>popkrunké</u> (Nearest Town)	
Date drilling started: <u>\$-27-18</u> Date of Location of the source of any surface wa Method of dosing and volume of Chloring Logs run (check <i>all applicable</i>): log run Name of organization running log(s): Purpose of borehole (check one): Water V	rilling completed: ter used for drilling a sused in drilling a felectric bamm Vell Geotechni Survey Other (ng: <u>exsisting</u> Well nd development: <u>Cranulate</u> na Ray Density Sonic Neutro	d Chrone	
Purpose of Well (check all applicable):	Home Industria	l Public Supply Irrigation	and the second	
If a flowing well, method of flow regulat Static Water Level: <u>130</u> feet	ion: Valve	Other (describe)		
Method of measurement (check <i>one</i>) St Well depth: <u>195</u> Well grouted to a d Casing length: <u>125</u> feet Cas Screen length: <u>20</u> feet Scr Screen slot size: <u>9</u> inches	epth of: <u>1</u> 6f ing diameter: reen diameter:	eet Type of grout (check one) <u>4</u> inches Type of c <u>4</u> inches Type of s	Aveat Cement Bentonite Mix asing: <u>من جمع تاری</u> screen: <u>من جمع تاری</u>	
Type of completion (check all applicable) Other (<i>describe</i>): Top of lap pipe or reduction in casing:	Fravel packed	Underreamed Open hole	Natural Development	

County:	pearl	River	
Permit #:			

The sketch below only required for water wells

If well telescopes, show depths on sketch.

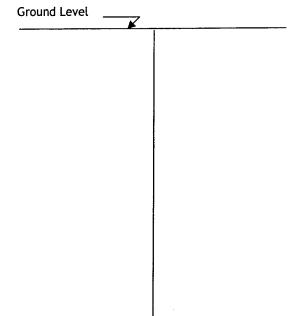

Description of formations encountered must be provided for all wells and boreholes, unless specifically exempted by regulations

Well #: ____

For Office Use Only: #: A34

Description of Formations Encountered	From (depth)	To (depth)
	Ground level	
Top Soil	υ Ο	3
Top Soil Fed clay	3	48
Sanit	48	83
Whitecky	83	110
Sand White cky Blue cky Sand	110	160
Sand	160	195
A Alexandra		

If more than one screen, show location of each on sketch

Sketch the property layout and include the following: Hay is 1) the well location 2) any permanent structures on the property that may aid in locating the well 3) any roads, power lines, or other items that may aid in locating the property and the well 4) north arrow Dearl COLUMBA HWY 43 N Perken Stevens /¥] Landowner Name: I HEREBY CERTIFY that the well/borehole was drilled, constructed, and completed in accordance with all applicable requirements of the Mississippi Department of Environmental Quality and the Mississippi Department of Health regulations, if applicable, and state laws. Signature of Licensee Form: OLW 8683 Print Name of Responsible Licensee and License No. Date Form: OLWR-SWR-1B (4/13)

Contract 12 12	SIAIE W	ELL REPORT Part 2		
County:	Pump Installer's Completion Report Mississippi Department of Environmental Quality Office of Land and Water Resources		For Office Use Only:	
Driller: Josh Boone			Well #: <u>A34</u>	
Date completed: 8-27-18	F	P.O. Box 2309	Aquifer:	
Copy information from block on Part 1		on, MS 39225-2309 601)961-5210	Aquiler	
	(601) 360-0535 (fax)		
This part of the report must be complete of the report must be attached and both	d by a licensed water parts filed with the L	r well contractor or a licensed pun Department at the above address w	np installer. A copy of Part 1 vithin 30 days of well completion.	
Well Owner Informati		Well Location		
Owner Name: 171 Stevens		Latitude: <u>36.58.52 N</u> Lon	gitude: <u>894334w</u>	
Mailing Address: 10338 1124 43		Method of Lat/Long (check one)	: Conventional Survey,	
		USGS quad, Hand-held GF	PS, Survey-grade GPS	
Lity State	37470	<u>NW 14 NW 14, Sec_</u>	<u>q t 15 r 17W</u>	
	•	$\frac{14}{(Distance)}$ Miles $\frac{1}{(Direction)}$ of	poplaruille	
Telephone No. (<u>985</u>) <u>516-4736</u>		(Distance) (Direction)	' '(Nearest Town)	
	Pump Ty	pe (check one)		
Submersible 🗹 Turbine 🗌 Air Lift 🔲 Centrifu				
Date Pump Installed: 8-27-18	F	Rated Pump Capacity:	Gallons Per Minute	
Is This Pump (check one): Mew Rep				
		pe (check one)		
Electric Diesel Gasoline Natural Gas				
Horse Power Rating of Motor:	Horse Power Rating of Motor: Setting Depth:feet Number of Stages:O			
	•	for Non Flowing Well		
Date Well Tested: <u>8-27-18</u>		Duration of Pump Test (minimu	um 4 hours): <u>4</u> hours	
Static Water Level (A): Feet Below Land Surface Pumping Water Level (B): Feet Below Land Surface				
Drawdown [(B) - (A)]:8	Feet Below Land Surf	ace Test Pumping Rate:	18 Gallons Per Minute	
Method of measurement (check one): St				
	Pump Test Dat	a for Flowing Well		
Measured shut in head: <u>130</u> feet.				
Well yielded <u>19</u> GPM with a d	rawdown of	feet after <u>4</u>	nours of pumping	
Meter Installation				
Meter Manufacturer:		Meter Serial Number:		
Meter Model Number/Name:	Type of Meter:		· · · · · · · · · · · · · · · · · · ·	
Totalizer Register Unit and Multiplier Factor (AF x .001, gal x 1000, etc):				
Installation Date: Meter installed by:				
Is This Meter (check one): New Repaired Replacement				
Important: By submitting the above information you are certifying that this meter was installed to manufacturer standards. For agricultural wells, a list of approved meters is on the MDEQ website.				
I HEREBY CERTIFY that the above statements are true to the best of my knowledge.				
La Ra	CH 60	8.27.18 A.	112,	
Josh Boone Print Name of Pump Installer and Licenso	No. (if applicable)	Date Signatu	ure of Pump Installer	
·······························			Form: OLWR-SWR-2A (4/13)	

orm: OLWR-SWR-2A (4/13)
------------------------	---