

Pearl River
 A-2000
 6-25-76

MISSISSIPPI
 BOARD OF WATER COMMISSIONERS
 416 North State Street
 Jackson, Mississippi 39201

WATER WELL DRILLERS LOG

6-25-76 Pearl River water well Pearl River
 date well completed firm name county well located

LANDOWNER: Frank L.
 Bonalona Sr.
 Route 7 Poplarville miss
 (mailing address)

description of formations encountered	from	to
Top clay	0	20
Fine sand	20	45
Red chalk	45	62
White chalk	62	140
Blue hard chalk	140	165
Fine to coarse	165	200

WELL LOCATION:

sec. 15 T. 1 N. R. 17 E.
 16 miles N.W. of Poplarville
 (distance) (direction) (nearest town)

WELL PURPOSE:

(home, irrigation, municipal, industrial)

WELL COMPLETION DATA:

- diameter (inches) 4"
- total depth (feet) 200'
- static water level (feet) 120 below above top of ground.
- casing P.V.C. 190 (material) (depth)
 (size) If telescope see back.
- screen 10' 190 (length) (depth to top)
- pump 1 20 (HP) (yield gpm)
 220 Volt A.C. (type power)
- electric log (yes or no)
- (organization running log)
- how well bottom plugged 2" Sand-Shark Valve


DRILLERS REMARKS:

and Drilling
 well

MISSISSIPPI BOARD OF WATER COMMISSIONERS

If well telescopes please sketch and show depths.

GROUND LEVEL

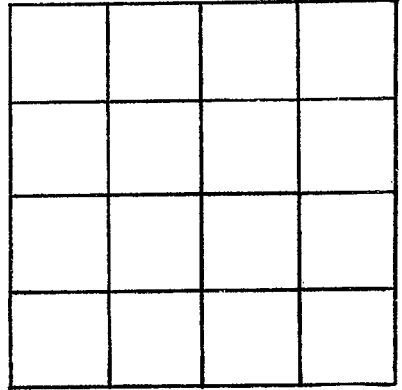

SECTION _____

Please indicate well location X.

ADDITIONAL INFORMATION

If more than one screen, show locations of each on sketch.